



**TENDER NOTICE NO.
HY/ES/LML MAULI/CIE/12**

**CIE jobs - Erection, Testing, Pre commissioning &
Commissioning of 1X30 MW STG Sets at Lokmangal Mauli
Industries, Osmanabad, Maharashtra**

Tender Submission

On or before 16 - January -2013, at 11.00 Hrs.

TENDER OPENING

On 16 - January -2013 at 13:30 Hrs.

at

VENDOR COMPLEX

BHEL, HYD (ADMIN BLOCK)

(Phone: 040 – 23183415 / 23183416 / 23184497)

BHARAT HEAVY ELECTRICALS LIMITED

Ramachandrapuram, Hyderabad-502032 (A.P.)



TENDER SCHEDULE

Spec. No.201

Lokmangal Mauli Industries, Osmanabad, Maharashtra 1x30 MW STG

(Page 1 of 1)

PROJECT INFORMATION

Installation, Testing & Commissioning of Control, Instrumentation and Electrical Jobs are to be carried for 1X30 MW Steam Turbine driven Generator Sets at M/S Lokmangal Mauli Industries, Osmanabad, Maharashtra.

PROJECT DATA

1. Project Authority : M/S Lokmangal Mauli Industries
Osmanabad, Maharashtra
 2. Project Consultant : NIL
 3. Name of the Project : Lokmangal Mauli Industries, Osmanabad, Maharashtra
 4. Location of Site : Lokmangal Mauli Industries, Distt.-Osmanabad,
Maharashtra
 5. Nearest Railway Station : Sholapur
 6. Nearest Air Port :
-

SIGNATURE & SEAL OF BIDDER



SCOPE OF WORK

Spec. No.202 Lokmangal Mauli Industries, Osmanabad, Maharashtra 1x30 MW STG (Page 1 of 10)

SCOPE OF CONTROL, INSTRUMENTATION AND ELECTRICALS JOBS

It is not the intention in this specification to specify each and every activity in the scope of work. However broadly they are brought out in this section and specification nos. 101, 102 & 103 of this Tender Schedule. Bidder may kindly note the same. For the completeness of the job, bidder to note that, all activities of erection, testing and commissioning should be completed. Any minor modifications including strengthening by additional welding etc., if required on the equipment to be erected shall be considered as part of the erection and shall not call for any extra payment.

- 1.0 Bidder should quote most competitive and "FIRM" Prices only. Tenders shall be evaluated on total cost basis (i.e. Grand Total in Summary Sheet). The terms of payment will be operated based on Specification 205 & 205A. Service taxes will be paid extra as per the prevailing government rate on submission of necessary documents.
- 2.0 Bidder should note at least 50% of Security Deposit should be paid before start of the work. Balance Security Deposit shall be recovered from running bills at the rate of 10% till full amount is recovered.
- 3.0 Receipt, Inspection, Storage and drawal of Materials at site:
- 3.1 After the materials (Instruments and associated items) are received at site, the contractor shall Identify them with reference to the completion schedules and relevant part lists and tag every item with the connected tag number with reference to P&I diagram. Any clarifications/assistance required for identifying the items will be extended by the BHEL Site Engineer. Instruments' Body (not the cover) shall bear tag no. in paint.
- 3.2 All the items shall be stored, after tagging, in separate locations service wise.
- 3.3 Temporary sheds required for the storage of these items shall be constructed by the contractor. Storage of these items shall be done in such a way that these can be reached and retrieved easily and conditions for storage are good, to the satisfaction of BHEL site engineer.
- 3.4 Materials drawn from BHEL / Contractor's store shall be transported to installation site as per requirement. The contractor shall make proper arrangements for safe transporting these materials to avoid damage or disturbance. The contractor shall also maintain a register and record the description and quantity of materials drawn by him from BHEL stores and their actual utilization. All entries made by the Contractor in the register shall be initiated by the BHEL's site Engineer. After completion of the works un-utilized instruments and associated items shall be returned to BHEL stores and due receipt obtained.

SIGNATURE & SEAL OF BIDDER



SCOPE OF WORK

Spec. No.202 Lokmangal Mauli Industries, Osmanabad, Maharashtra 1x30 MW STG (Page 2 of 10)

4.0 ERECTION OF INSTRUMENTATION

- 4.1 The Contractor shall, execute the entire instrumentation work within the battery limits as indicated in BHEL drawings and the work includes erection, testing, calibration, and commissioning of instrumentation and control panels and gauges, boards for all equipment and associated auxiliaries.
- 4.2 BHEL will furnish the contractor with necessary P&I diagrams in which all the instruments required for the control & protection of the system are shown.
- 4.3 The Contractor shall erect all local instruments and junction boxes in the field with suitable and permanent supports as per BHEL standards. Vibration free locations at which instruments shall be installed will be indicated by BHEL site engineer.
- 4.4 The mechanical contractor will provide necessary tap off points on the equipment, vessels, auxiliaries and pipe lines up to the first isolation valve. The CIE contractor shall carryout further process connection from these tap off points to various instruments like pressure gauges, pressure transmitter, differential pressure transmitters, pressure switches etc. All temperature gauges with capillary type should be mounted on separate stand and capillary to be routed in separate perforated tray.
- 4.5 The process line connections between the tap off points and respective instruments shall be carried out in accordance with the BHEL standards furnished to the contractor, or as instructed by BHEL Engineer at site.
- 4.6 The contractor shall route process impulse lines from the respective tap off points up to the primary instruments via the shortest possible route employing minimum number of bends. They shall be carried out with the concurrence of the BHEL site engineer.
- 4.7 The instrument air (2" header) for each services will be provided at the battery limit of the respective services. The instrumentation contractor shall route the instrument air header to the local control panels and the various local pneumatic instruments, which shall be carried out under the supervision of BHEL site Engineer.
- 4.8 The CIE contractor shall install an isolation valve and air filter regulator near the local instrument on a permanent support and carryout connections from air header to various pneumatic instruments.
- 4.9 The Contractor shall connect the primary pneumatic instruments to the secondary instruments as per the P & I diagrams by means of 6 X 1 mm PVC covered copper tubes / S. S. tubes joined by S.S. socket weld straight coupling by Argon welding, or compression fittings as required at site.

SIGNATURE & SEAL OF BIDDER



SCOPE OF WORK

Spec. No.202 Lokmangal Mauli Industries, Osmanabad, Maharashtra 1x30 MW STG (Page 3 of 10)

- 4.10 The Contractor shall plan the routing of pneumatic impulse lines and cables with the concurrence of BHEL Engineer. He shall carryout pre-modifications suggested by BHEL site Engineer in line with layout of pneumatic tubes and electrical cables, wherever found necessary.
- 4.11 After finalizing routing plan for cables and tubes, the contractor shall erect slotted sheet metal trays/angle trays as the case may be from the local instruments and junction boxes up to panels & gauge boards and from the junction boxes to the local control panels. The Contractor shall use natural bends wherever slotted sheet metal/ angle tray junctions are encountered. These cable trays shall be erected securely and shall be fixed to the walls or steel beams with proper support or with hangers. The routing shall be carried out in such a way that they should be kept away from hot environment and allow enough room to lay additional cables easily at a later date.
- 4.12 The contractor shall lay pneumatic tubes and electrical cables on independent trays. All cables shall be protected at both ends and also strands shall be ferruled for easy testing and termination. All tubes, cables shall be laid properly and fixed securely to the trays by means of clamps. All junction boxes shall be numbered using paint as per the directions of BHEL site engineer.
- 4.13 Metallic tags inscribing the junction box number shall be tied securely to the cable or tube at the primary elements like pressure transmitters, pressure switches, etc. and a metallic tag at the junction boxes inscribing the tag number of the instrument.
- 4.14 The contractor shall connect multi-tube/ multi-core cables to the control panel bulk head/terminal box from the respective junction boxes. Multi-cable/multi-tube shall be laid in the same way as mentioned before, and shall be secured by cable glands/ bulk heads.

5.0 CONTROL PANELS & LOCAL GAUGE BOARDS:

- 5.1 Panel erection shall include chipping, levelling, grouting, fabrication of base frame if required and modifications in panel wiring if any, removal of instruments/ relays for calibration, testing and re-fixing of the same after calibration / testing.
- 5.2 Gauge boards, as and when received at site, shall be unloaded, cleaned and shall be immediately installed at location as shown in layout / as suggested by BHEL engineer.
- 5.3 The Contractor shall drill required No. of holes on gland plates of panels and local gauge boards for entry of electrical cables, pneumatic tubes and process impulse lines. All cables shall be provided with suitable glands. Any extra hole shall be plugged to avoid dust/moist air entry into panel.

SIGNATURE & SEAL OF BIDDER



SCOPE OF WORK

Spec. No.202 Lokmangal Mauli Industries, Osmanabad, Maharashtra 1x30 MW STG (Page 4 of 10)

- 5.4 All cables & pneumatic tubes shall be identified and tagged with the instrument tag numbers connected to terminal strip/bulk heads as per the panel drawing supplied to the contractor.
- 5.5 On completion of work, all carbon steel components viz, impulse line, instrument supports, angles, cable racks shall be properly cleaned and painted firstly with a coat of suitable/applicable primer and double coat of suitable / applicable anti corrosive paint.

6.0 CALIBRATION AND TESTING:

- 6.1 All local pneumatic/ electrical instruments shall be calibrated, aligned, and set as per the data furnished and priority set by BHEL Engineer. Calibration shall be carried out by the contractor in the presence of BHEL Engineer or staff deputed by BHEL Engineer. The contractor shall fill in the pro-forma for each instrument indicating data, tag. No, service, instrument make, and calibration values etc. Each pro forma shall be signed by BHEL Engineer and customer's representative.
- 6.2 All panel instruments, service wise, shall be calibrated, aligned and set as per the data furnished by BHEL Engineer in the order of priority. The Contractor shall fill in the pro forma as said above and shall be signed by BHEL Engineer & Customer representative.
- 6.3 Calibration of all local instruments and instruments mounted on local gauge boards and control panels shall be carried out in position as far as possible and any deviation shall be duly certified by BHEL Engineer.
- 6.4 All control valves shall be checked/ calibrated for full range operation with required pneumatic/electric signal. Report shall be prepared and countersigned by BHEL Engineer/Customer Engineer.
- 6.5 All safety valves shall be removed by the mechanical contractor. The instrument contractor shall carry it to the instrument room, to be checked with the set value as advised by the BHEL engineer and if necessary contractor shall adjust and set value. Contractor shall fill in pro-forma indicating the service, tag No. set value etc. and BHEL engineer and customer's representative shall sign. After setting the safety valve shall be handed over to mechanical contractor for installation in its original position.
- 6.6 The contractor shall carry hydraulic test for all process impulse lines with 1.5 times the normal operating pressure of the line, isolating the instrument. The test pressure shall be maintained for thirty minutes. If any leak is found in the process impulse line the contractor shall rectify the same. After rectification, hydraulic test shall be carried out once again & BHEL Engineer shall certify each line after successful hydraulic test.

SIGNATURE & SEAL OF BIDDER



SCOPE OF WORK

Spec. No.202 Lokmangal Mauli Industries, Osmanabad, Maharashtra 1x30 MW STG (Page 5 of 10)

- 6.7 Contractor shall arrange for necessary standard test equipment/kits required for calibration of instruments. Test equipment / instruments shall be accredited by an authorized agency or the OEM & a copy of the certificate, indicating accuracy, validity period of the instrument usability etc., shall be furnished to BHEL engineer for approval.
- 6.8 All pneumatic impulse lines shall be tested by the contractor for leakages at connections with air/nitrogen at a pressure of 10kg/sq. cm. or at the value advised by BHEL Engineer, isolating instruments and with soap solution for loop checking. If any leakage is found contractor shall rectify the same and repeat the test. The Contractor shall obtain signature of BHEL Engineer for each line after successful testing.
- 6.9 All pneumatic air headers shall also be tested by the contractor in the same way as mentioned in 6.8.
- 6.10 All electrical cables shall be tested for continuity and insulation. Contractor shall earth the equipment and cables where ever required as per BHEL Engineer's advice.

7.0 PNEUMATIC LOOP CHECKING:

- 7.1 All pneumatic loops shown in P & I schemes shall be checked / tested for their functioning. The loop shall include primary elements and final elements etc. The loop shall be checked / tested by simulating the process condition by means of variable inputs to the primary elements/transducers. If any of the instrument's calibration is found drifted, the contractor shall re calibrate the instrument and check the loop again.
- 7.2 The Contractor shall check/test all panel internal Electrical / Pneumatic circuitry with ref to the panel drawings / schemes, and if any deviations noticed, he shall intimate the BHEL Engineer and shall act as per his advice.

8.0 PRE-COMMISSIONING AND COMMISSIONING:

- 8.1 All electrical switches connected to the trip / inter lock circuit shall be checked / tested for their functioning by simulating the service condition.
- 8.2 On advice of BHEL Commissioning Engineer, contractor shall put all instruments in line with the process. The Contractor shall modify the settings or ranges in case suggested by the BHEL Commissioning Engineer. During Commissioning of main equipment and other related equipment / auxiliaries, the contractor shall fine tune instruments in auto control mode to suit system requirements.

SIGNATURE & SEAL OF BIDDER



SCOPE OF WORK

Spec. No.202 Lokmangal Mauli Industries, Osmanabad, Maharashtra 1x30 MW STG (Page 6 of 10)

- 8.3 Before charging pneumatic supply air header, the lines shall be blown for a period specified by BHEL Engineer at full parameter and all signal tubes shall be blown at least once.
- 8.4 When the pre-commissioning activities are concluded, the contractor shall render all necessary help to BHEL Commissioning Engineer in regard to CIE during the commissioning of the main equipment.
- 8.5 Contractor shall co-operate with BHEL and customer in reviewing the progress and method of work.
- 9.0 Preparation & Submission of Documentation includes Instrument Calibration or electrical test equipment accreditation / fitness certificate, field instrument calibration report, Panels/ Bus-duct/ relays test report , loop checking, control & logic checking etc., Erection, Pre commissioning & Commissioning protocol on prescribed format approved by BHEL/Client/ Consultant and as build drawings if any. Site activities viz. Installation / Pre commissioning / commissioning documents / protocols to be submitted in FIVE copies. No separate charges will be applicable.
- 10.0 The unit rates for all items mentioned in specification number 204 covers erection, testing, calibration, loop checking, pre commissioning ,commissioning, preparation & submission of five copies of report/protocol (as detailed in clause 9.0) etc. unless stated otherwise.
- 11.0 Necessary tools and accessories like crimping material, identification tag ferrules, U clamps, bolts & nuts etc. required for laying pneumatic tubing, impulse tubing & piping, are not in BHEL scope of supply. The same has to be supplied by the contractor.
- 12.0 Erection of instruments shall include fabrication of instrument stands and hardware like nut & bolt for mounting instruments on to stands. For instrument stands fabrication consumable like gas, welding rods, nuts, bolts and anchor fasteners etc. are also in contractor's scope.**
- 13.0 Erection, calibration, testing, loop checking and commissioning of Local, Field and Panel mounted instruments, Relays, CTs & PTs Panels, Valves, Junction boxes, Proximeter housings, Impulse lines, cables between local / field mounted instruments to JBs & JBs to Turbine / Generator control & relay panels. Cable trays for Turbine and Generator and its auxiliaries and some materials are to be supplied by the contractor and the same are mentioned clearly in specification No. 204.
- 14.0 Un-armored Communication cable to be laid through GI pipes/ conduits. The GI pipe/ conduit along with the necessary fittings & supports are to be supplied by bidder. Bidder shall include the cost of the same along with cable laying.

SIGNATURE & SEAL OF BIDDER



SCOPE OF WORK

Spec. No.202 Lokmangal Mauli Industries, Osmanabad, Maharashtra 1x30 MW STG (Page7 of 10)

-
- 15.0 Cable laying shall include drilling of gland holes, dressing & clamping of cables using Aluminium clamps on trays, glanding, tagging, ferruling, terminations & continuity checking. Consumables like Cable Glands, aluminium tags, lugs and ferrules shall be supplied by erection contractor and their cost is deemed to be included in the unit rates quoted. All cable ferruling should be printed / punched and cross ferruled. Single and loose ferruling is not acceptable.
- 16.0 For cable tray / duct erection and some instruments, mounting support structures and stands are to be fabricated as per BHEL engineer's guidelines. For this work no separate rate will be applicable. Hence this job including materials for support structures and stands, fasteners like nuts, bolts, washers etc., shall be included in the unit rates of cable tray/duct / instrument erection. For cable tray/duct erection the tray /duct couplers, bolts, nuts, washers etc., are to be supplied by the contractor.
- 17.0 Mounting of loose supplied items, includes termination of loose wires to the mounted items with proper ferruling and any modification of wiring with printed/ punched cross ferruling if necessary or as suggested by BHEL Site engineer as per O & M requirements.
- 18.0 **Proximeter housing & installation of junction boxes includes making of required hole for cable entry on the housing(if required) and fabrication of structure for the same & painting. For fabrication of structure consumables like welding electrode, gas, nuts, bolts etc. including paint with primer are to be supplied by the contractor.**
- 19.0 Installation of TSI probes shall include support tube erection, support tube modification & re-threading (if required), installation of support tubes, installation of protective flexible conduit and clamping using aluminium clamps. Aluminium clamps are to be provided by bidder.
- 20.0 Bidder shall make his own arrangements for material handling, shifting of materials from store to site and tools & tackles, hoisting equipment etc., during the erection period.
- 21.0 Process impulse piping & tubing includes oil, steam, condensate, cooling water and gas scheme etc. and pneumatic tubing fabrication & erection with all the fittings, valves etc., and hydraulic tests are in the contractor's scope. No separate payments are applicable. Necessary tools & accessories like clamping bolts, nuts, U clamps, tags etc for laying pneumatic tubing, process impulse piping are to be arranged by the contractor. No separate payments are envisaged. Impulse tubing & piping jobs are to be carried out as per enclosed BHEL "Instruments Hook up Diagrams" Drawing No 4-312-00-50126 Rev.00 (Annexure-2) and "Instrument Installation Drawing" Drg. No. 4-381-21-03032 Rev 02 (Annexure-3).

SIGNATURE & SEAL OF BIDDER



SCOPE OF WORK

Spec. No.202 Lokmangal Mauli Industries, Osmanabad, Maharashtra 1x30 MW STG (Page 8 of 10)

-
- 22.0 Calibration of safety relief valves and control valves, loop checking, re-fixing and commissioning is under the scope of bidder.
- 23.0 Bidder shall agree to keep the rates valid for any variation in quantities indicated in Price Schedule.
- 24.0 Bidder to note that the construction power and water will be provided at a single point at fabrication area or at site. The successful bidder shall have to make necessary arrangements for cables energy meters & safe distribution etc., by himself. The bidder has to ensure that the statutory regulations are met with while executing the work. **Bidder to note that the construction power and water shall be chargeable as per BHEL client's terms and condition.**
- 25.0 **PAINTING: The Bidder shall consider about 5 (five) coats of painting (supply and application including the primer for Epoxy paint) for the items to be erected i.e. Instrument stands, panels, piping and auxiliaries etc., and the work is subject to inspection / approval by BHEL's client. All piping & structural materials are to be sand blasted before painting. Sandblasting, supply and application of paint are in bidders' scope. No separate payments are envisaged.**
- 26.0 The bidder shall submit test and calibration reports for protection /auxiliary relays, instruments, control & safety valves, cables etc. including pre commissioning & commissioning report as per the BHEL/CUSTOMER formats in five copies.
- 27.0 During erection, testing, pre- commissioning and commissioning works, some repairs, rectification and modifications etc. are likely to occur. Contractor should note that they are part of erection, testing, pre-commissioning and commissioning scope. No extra payment will be entertained on this account.
- 28.0 For any extra equipment & structural jobs, the approved unit rates of erection only will be applicable, and this will not be treated as extra work for payment on man hour rates basis.
- 29.0 The bidder shall consider testing of CTs & PTs in bus duct / generator phase & neutral side terminal boxes erection (if applicable), Relays & Panel instruments as a part of panel erection, testing commissioning. No separate payments are envisaged.
- 30.0 Bidder shall consider that PLC erection & commissioning includes assembly / mounting and testing of loose parts whatever supplied along with PLC cabinets. No separate payments are envisaged.
- 31.0 **Bidder to note that they have to provide commissioning assistance as per the site requirement during commissioning. No separate payments are envisaged and the unit rates quoted for erection and commissioning are deemed to have taken care of this requirement. Commissioning is deemed to be completed on successful run of the unit for 72 hours, uninterrupted allowing for minor variation in load.**

SIGNATURE & SEAL OF BIDDER



SCOPE OF WORK

Spec. No.202 Lokmangal Mauli Industries, Osmanabad, Maharashtra 1x30 MW STG (Page9 of 10)

- 32.0 Segregated Phase Bus-duct and Accessories erection including erection of open bus- bar, flexible links, etc. with support insulators & structural support (supplied by the vendor) inside generator air cooling chamber from generator terminal to Seal off bushing and erection of structure for bus-duct support (supplied by the bus duct vendor) as per the drawing attached. **Considering the criticality & specialized nature of this job bidder is to ensure vendor supervision during the job execution & no separate charges are applicable in this regard.**
- 33.0 CO2 piping erection includes fixing of CO2 nozzle, tubing from CO cylinder with tube fittings, threading, welding of pipes as per the lay out drawing, after consulting with BHEL engineer / Customer / Consultant representative. This is in consideration of O & M aspects from Customer side. Tools, tackles and consumables for carrying out the job are to be arranged by bidder.
- 34.0 **ACCEPTANCE OF THE TENDER**
Acceptance of the tender will be intimated to the successful bidder through a Letter of intent / Fax of intent. The contractor shall then be required to execute an agreement annexed (Annexure I & II), within seven (7) days from the date of issue of the letter of Intent. In the event of failure on the part of the contractor to sign the agreement within the specified time, the earnest money deposit shall be forfeited and the bidder shall be considered as withdrawn.
- 35.0 **CONTENTS OF THE CONTRACT DOCUMENTS**
The letter of submission of tender, notice inviting tender, scope of inquiry, Instruction to tenderers, general conditions of contract, general and technical specifications, tender proposal forms, tender drawings, contract form between the contractor and BHEL, forms of different deeds (as applicable), amendments / addenda / corrigenda and interpretations / clarifications as issued by BHEL subsequent to issue of tender documents (if any), contractor's tender
No..... dated all correspondences, minutes of meetings, agreed variations etc., between the tenderer and BHEL till issue of the letter of intent by BHEL, agreed quality assurance programme and time schedule network together with the letter of intent issued by BHEL, all pertaining to this tender, agreed man power deployment together with their technical qualifications etc., shall form the contract.
- 36.0 The contract document shall contain, the scope of inquiry, general and technical specifications and amendments / addenda / corrigenda, interpretation / clarifications issued by BHEL on technical aspects, as well as all correspondences, minutes of meetings etc., between the bidder and BHEL on technical aspects, agreed quality assurance programme, time schedules network, and the rest of documents listed in clause 35.0 above.

SIGNATUR E & SEAL OF BIDDER



SCOPE OF WORK

Spec. No.202 Lokmangal Mauli Industries, Osmanabad, Maharashtra 1x30 MW STG (Page10 of 10)

37.0 The bidder shall prepare, one (1) Original of Contract as described in clause 34.0, 35.0 & 36.0 within seven (7) days of signing the contract agreement and shall arrange six (6) true copies of contract documents free of charge within 4 weeks from the date of signing the contract agreement. After retaining one copy with them for their use, the contractor shall hand over remaining 5 copies to BHEL for their use at site & headquarters including their finance department.

SAFETY:

Observation & complying with standard applicable Safety norms during job execution is of paramount importance to BHEL. Contractor / their authorized representatives shall adhere to the safety norms as applicable in line with tender schedule which forms an integral part of the work order. Also an annexure covering, engineering standards and practices prevalent in works is enclosed for bidder's reference. Since the erection work shall be carried out in close proximity to operating plant, necessary safety / work permits shall be obtained from whom so ever, authorized to issue, prior to commencement of any job at site. Contractor shall appoint and inform BHEL site office the name & qualification of the person / persons who shall be responsible for safety during job execution. For safety related issues contractor safety supervisor will work in close coordination with Safety Officer authorized by customer.

SAFETY REGULATIONS

Contractor will ensure that trained men attend work in safe apparel and are provided with requisite safety appliances (PPE), tools & tackles etc. there by ensuring safe working conditions. The work to be carried out under the supervision of nominated safety supervisor only. For commencement of job contractor shall use duly tested tools/ tackles/appliances /(PPE) as per statutes in force and a copy of test certificates shall be produced to BHEL / Customer Site engineer/ safety officer on demand. Bidder shall be solely responsible and shall ensure that all safety requirements under relevant statutes in force are complied with. In case of failure to observe above regulations while undertaking the job BHEL/Customer Site engineer/ safety officer can order to stop work.

- Note: 1) Instruments used for calibration and testing should be certified by an accredited agency, as per our quality policy. Certificate of accreditation should be valid through the period of contract.
- 2) Licensed electrical supervisors should execute the work at site.
- 3) The bidder shall take necessary clearances and approvals from local/state Electrical Inspectorate / any related statutory authority. It is deemed that the bidder has considered any expenditure that he may be incurring in order to obtain needed licensees or relevant approvals from concerned authorities while quoting unit rates. Separate charges shall not be entertained on this account.
- 4) BIDDER SHALL NOTE THAT TENDER HAS TO BE FILLED IN ORIGINAL SCOPE FORMAT (SPEC NO. 204) SUPPLIED BY BHEL. RE- TYPED OR FORMAT WITH CHANGES/CORRECTIONS (SPEC NO. 204) WILL LEAD TO CANCELLATION OF BID.

SIGNATURE & SEAL OF BIDDER



ERECTION SCHEDULE

Spec. No.203

Lokmangal Mauli Industries, Osmanabad, Maharashtra 1x30 MW STG (Page1 of 1)

The Schedule for completion of Erection, Calibration, testing, loop checking and commissioning of control Instrumentation and Electricals for Main equipment, auxiliaries and piping shall be tentatively as below:

SL.No	DESCRIPTION	DATES
1.	Start of Erection	January 2013
2.	Commissioning of Turbine	August 2013
3.	Load run	September 2013

For the purpose of contract, the contract period shall be taken as 9 months. Completion of the work shall be as per BHEL work schedule, revised from time to time. However schedule may be advanced also. In order to expedite the work, the contractor has to deploy manpower on two-shift basis, if required, **without any extra cost to BHEL.**

SIGNATURE & SEAL OF BIDDER



CIE PRICE BID

Spec. No.204 Lokmangal Mauli Industries, Osmanabad, Maharashtra 1x30 MW STG (Page1 of 7)

SCOPE : ERECTION, CALIBRATION, TESTING, LOOP - CHECKING & COMMISSIONING

1.01.00 - LOCAL / FIELD MOUNTED INSTRUMENTS

SL.NO	DESCRIPTION	UNIT	QTY	UNIT RATE	TOTAL COST
1.01.01	PRESURE GAUGES	NOS	101		
1.01.02	BIMETTALIC THERMOMETERS	NOS	42		
1.01.03	MERCURY IN STEEL THERMOMETERS	NOS	15		
1.01.04	LEVEL GAUGES	NOS	7		
1.01.05	DIFFRENTIAL PRESSURE INDICATORS & SWITCHES	NOS	9		
1.01.06	PRESSURE SWITCHES	NOS	31		
1.01.07	LEVEL SWITCHES	NOS	10		
1.01.08	LEVEL TRANSMITTER	NOS	3		
1.01.09	SPEED MEASURING LOOP NOS	NOS	5		
1.01.10	VIBRATION, AXIAL DISPLACEMENT, VELOCITY PROBES	NOS	18		
1.01.11	RTD WITH THERMOWELLS	NOS	10		
1.01.12	BEARING THERMOELEMENTS	NOS	14		
1.01.13	THERMOELEMENTS (K-TYPETHERMOCOUPLE)	NOS	15		
1.01.14	ELECTRONIC PRESUTRETRANSMITTERS	NOS	25		
1.01.15	PROXIMITTERS	NOS	19		
1.01.16	THERMOWELLS	NOS	94		
1.01.17	CONTROL VALVES	NOS	7		
1.01.18	DE SUPERHEATER STATION	NOS	1		
1.01.19	I/H CONVERTOR	NOS	1		
1.01.20	LIMIT SWITCHES	NOS	8		
1.01.21	SOLENOID VALVE	NOS	4		
1.01.22	DIFFERENTIAL PRESSURE TRASNMITTERS	NOS	7		
1.01.23	AIR FLOW ROTAMETER	NOS	3		
1.01.24	PRESSURE SAFETY VALVE	NOS	1		
	TOTAL				

Note : Above rates are exclusive of govt. service taxes which are to be paid as extra.

SIGNATURE & SEAL OF BIDDER



CIE PRICE BID

Spec. No. Lokmangal Mauli Industries, Osmanabad, Maharashtra 1x30 MW STG (Page 2 of 7)

1.02.00 - PANELS & CUBICLES

1.02.01	LOCAL GAUGE RACK 1300 (w) X 1600 (h)	NOS	01		
1.02.02	GOVERNING CONSOLE BOARD 1300(w) X 1800(h) X 450 (d)	NOS	01		
1.02.03	TURBINE CONTROL PANEL 1600 (H) X 2300(W) X 800(D)	NOS	01		
1.02.04	AUTOMETIC VOLTAGE REGULATOR 2000(L) X 2200(H) X 1250(D)	NOS	01		
1.02.05	GENERATOR CONTROL PANEL 1000(L) X 2200(H) X 1000(D)	NOS	02		
1.02.06	GENERATOR RELAY PANEL 800(L) X 2200(H) X 800(D)	NOS	01		
1.02.07	GEAR BOX STARTER PANEL 800 (L) X 1200 (H) X 300 (D)	NOS	01		
	TOTAL				

Note : Above rates are exclusive of govt. service taxes which are to be paid as extra.

SIGNATURE & SEAL OF BIDDER



CIE PRICE BID

Spec. No.204 Lokmangal Mauli Industries, Osmanabad, Maharashtra 1x30 MW STG (Page 3 of 7)

1.03.00 - PANELS MOUNTED INSTRUMENTS.

1.03.01	TSI RACK WITH DESK TOP PC & PRINTER	NOS	01		
1.03.02	WOODWARD GOVERNOR	NOS	01		
	TOTAL				

1.04.00 - JUNCTION BOXES & LOCAL CONTROL STATIONS (LCS)

1.04.01	ELECTRICAL JUNCTION BOXES 12 INLET / 2 OUTLET	NOS	19		
1.04.02	ELECTRICAL JUNCTION BOXES 8 INLET / 2 OUTLET	NOS	15		
1.04.03	WEATHER PROOF JUNCTION BOXES 8 INLET / 2 OUTLET	NOS	13		
1.04.04	PROXIMETER HOUSINGS	NOS	09		
	TOTAL				

Note : Above rates are exclusive of govt. service taxes which are to be paid as extra.

SIGNATURE & SEAL OF BIDDER



CIE PRICE BID

Spec. No.204

Lokmangal Mauli Industries, Osmanabad, Maharashtra 1x30 MW STG (Page 4 of 7)

1.05.00 - PROCESS AND PNEUMATIC TUBING & PIPING

SL.NO	DESCRIPTION	UNIT	QTY	UNIT RATE	TOTAL COST
1.05.01	CS PIPE 21.3 X 3.73	MTR	450		
1.05.02	Cr-Mo PIPE 21.3 X 3.73	MTR	700		
1.05.03	SS TUBE 12.7 X 2.1	MTR	350		
1.05.04	SS TUBE 21.3 X 3.7	MTR	950		
1.05.05	SS TUBE 21.3 X 4.8	MTR	150		
1.05.06	CS PIPE 60.3 X 3.91	MTR	250		
1.05.07	SS PIPE 6.3 X 0.9	MTR	70		
	TOTAL				

1.06.00 - CABLES (LAYING ,TERMINATION & TESTING)

1.06.01	1P X 1.5 SQ. MM SIGNAL CABLE	MTR	5000		
1.06.02	6P X 1.5 SQ. MM SIGNAL CABLE INDIVIDUAL & OVERALL SHIELD	MTR	500		
1.06.03	12P X 1.5 SQ. MM SIGNAL CABLE INDIVIDUAL & OVERALL SHIELD	MTR	450		
1.06.04	1T X 1.5 SQ MM COPPER CABLE	MTR	600		
1.06.05	10T X 0.5 SQ MM COPPER CABLE	MTR	1000		
1.06.06	3C X 4 SQ MM COPPER CABLE	MTR	1200		
1.06.07	3C X 6 SQ MM COPPER CABLE	MTR	500		

Note : Above rates are exclusive of govt. service taxes which are to be paid as extra.

SIGNATURE & SEAL OF BIDDER



CIE PRICE BID

Spec. No.204 Lokmangal Mauli Industries, Osmanabad, Maharashtra 1x30 MW STG (Page 5 of 7)

SL.NO	DESCRIPTION	UNIT	QTY	UNIT RATE	TOTAL COST
1.06.08	5C X 2.5 SQ MM CONTROL CABLE	MTR	2000		
1.06.09	10C X 2.5 SQ MM CONTROL CABLE	MTR	1300		
1.06.10	1P THERMOCOUPLE EXTENSION CABLE	MTR	600		
1.06.11	2T X 1.5 SQ. MM SHIELDED CABLE	MTR	600		
	TOTAL				

1.07.00 - ERECTION OF CABLE TRAYS & CABLE DUCT.

1.07.01	PERFORATED CABLE TRAY L=2.5M, W=50MM	NOS	500		
1.07.02	COUPLER PL+ FASTENERS OF CABLE TRAY W=50, F=25	NOS	400		
	TOTAL				

1.08.00 - FABRICATION,ERECTION OF STRUCTURAL STEEL

1.08.01	STRL ST CHANNEL 100 X 50	MTR	25		
1.08.02	ANGLE 50 X 50 X 6	MTR	100		
1.08.03	ANGLE 75 X 75 X 6	MTR	20		
1.08.04	PLATE 6 MM THICK 1500 X 5000	NOS	2		

Note : Above rates are exclusive of govt. service taxes which are to be paid as extra.

SIGNATURE & SEAL OF BIDDER



CIE PRICE BID

Spec. No.204 Lokmangal Mauli Industries, Osmanabad, Maharashtra 1x30 MW STG (Page 6 of 7)

1.09.00 - SEGREGATED PHASE BUSDUCT & ACCESSORIES(To be carried out Under the supervision of M/s Spaceage as per Drawing No.BD11-283C-1286)

1.09.01	BUSDUCT (1400X500)	MTR	15		
1.09.02	3-Phase Tap off BUSDUCT (1400X500)	MTR	2		
1.09.03	PTSP CUBICAL 1950 (L) X 1900 (D) X 2200 (L)	NOS	1		
1.09.04	NGT 1250 (L) X 1250 (D) X 1500 (H)	NOS	1		
1.09.05	1-Phase Tie-Duct for NGR	MTR	12		
1.09.06	SUPPORT STRUCTURE	TON	2		
	TOTAL				

Note : Above rates are exclusive of govt. service taxes which are to be paid as extra.

SIGNATURE & SEAL OF BIDDER



CIE PRICE BID

Spec. No.204

Lokmangal Mauli Industries, Osmanabad, Maharashtra 1x30 MW STG (Page 7 of 7)

SUMMARY SHEET

1.01.00	LOCAL / FIELD MOUNTED INSTRUMENT (1.01.01 TO 1.10.24)	
1.02.00	PANELS & CUBICALS (1.02.01 TO 1.02.07)	
1.03.00	PANEL MOUNTED INSTRUMENT (1.03.01 TO 1.03.02)	
1.04.00	JUNCTION BOXES & LOCAL CONTROL STATIONS (LCS) (1.04.01 TO 1.04.04)	
1.05.00	PROCESS & PNEUMATIC TUBING FITTING (1.05.01 TO 1.05.07)	
1.06.00	CABLES (1.06.01 TO 1.06.11)	
1.07.00	ERECTION OF CABLES TRAYS & CABLE DUCTS (1.07.01 TO 1.07.02)	
1.08.00	FABRICATION, ERECTION OF STRUCTURAL STEEL (1.08.01 TO 1.08.04)	
1.09.00	SEGREGATED PHASE BUSDUCTS & ACCESSORIES (1.09.01 TO 1.09.06)	
	GRAND TOTAL	

Note : Above rates are exclusive of govt. service taxes which are to be paid as extra.

SIGNATURE & SEAL OF BIDDER



TERMS OF PAYMENT - SECTION VIII

Spec. No.205

Lokmangal Mauli Industries, Osmanabad, Maharashtra 1x30 MW STG (Page 1 of 1)

The contractor shall submit Progress of work weekly with certification of computation of work from BHEL Site Engineer. The contractor may raise bill for the work carried out monthly as per rate accepted.

Payment to the contractor for the work done will be regulated as follows:

- a) 50% of each item will be paid on completion of the erection and calibration of the items as applicable against progressive running bills.
- b) 35% value of each item shall be paid on completion of testing, painting / final painting and putting into services as applicable against progressive running bills.
- c) 5% of the value shall be paid on submission of E & C Documentation (Calibration / test equipment fitness certificate, Protocol, test reports, as-built drawings, etc.,)
- d) 5% of the value shall be paid on commissioning of set after taking into consideration total value.
- e) Final 5% of the total shall be paid after the expiry of the guarantee period. All payments shall be released from our headquarters at Hyderabad after the bills are duly certified by BHEL Site engineer & Construction Manager.
- f) Security deposit will be deducted as per rules and paid on completion of guarantee period.

NOTE:

- 1) For supply items 85% cost of the items will be paid after receipt of material at site in good condition and acceptance thereof against Progressive running bills.
- 2) Balance payments for supplies will be released as per paras (d) and (e) above.

SIGNATURE & SEAL OF BIDDER



MAN HOUR RATES

Spec. No.205A

Lokmangal Mauli Industries, Osmanabad, Maharashtra 1x30 MW STG (Page 1 of 1)

Bidder shall consider the following single man-hour rate including cost of supervision and consumables for all categories of extra works that may arise during course of contract. Bidder to note that these rates shall not be applicable for, modification / rectification of works executed defectively contrary to the instructions of Engineers and drawings.

Sl. No.	DESCRIPTION	MAN HOUR RATE
1.	SKILLED / SEMI SKILLED / UN SKILLED	Rs. 25/-

SIGNATURE & SEAL OF BIDDER

DRAWINGS FOR 11KV, 2500A SPB.

REFERENCE DRAWING:

1. FOR EQUIPMENT LAYOUT FOR TG BUILDING GROUND FLOOR, EL. 10.0M DWG. NO. 1-381-01-04779 REV.03.
2. FOR LAYOUT GENERATOR DWG. NO. 1-139-12-31324, REV.02.
3. FOR CLOSED CIRCUIT AIR COOLING SYSTEM DWG. NO. 0-139-31-31269, REV.06.
4. FOR TERMINAL ARRANGEMENT OF GENERATOR DWG. NO. 1-135-08-31438, REV.01.
5. FOR PANEL ROOM LAYOUT FOR TG HALL AT VARIOUS LEVELS DRW. NO.-1291799000466, REV.-04-S02.
6. FOR 11KV MV PANEL DRAWING NO.-896-1339.9

AS BUILT DRAWING

PROJECT
LOKMANGAL MAULI INDUSTRIES LTD.
1 X 30 MW STG, OSMANABAD, MAHARASHTRA
CUSTOMER
M/s BHARAT HEAVY ELECTRICALS LTD. HYDERABAD.

REV. NO.	DESCRIPTION OF CHANGE	DATE	SIGN.	DRN.	DATE	DRG. TITLE:	DRG. NO.	REV. NO.	
				ANAND	11.05.12	 SPACEAGE SWITCHGEARS LIMITED 68, INDUSTRIAL DEVELOPMENT COLONY, GURGAON-122001			
				CHD.	ANAND				
				ANAND					
03	AS BUILT DRAWING	18.12.12	MOHIT						
02	DRAWING REVISED AS PER CUSTOMER COMMENTS/INPUT RECEIVED ON 23.06.12	26.06.12	ANAND						
01	DRAWING REVISED AS PER CUSTOMER COMMENTS/INPUT RECEIVED ON 15&23.05.12	12.06.12	ANAND	APPD.	V.PAL	FRONT COVER SHEET FOR 11KV, 2500A SPB.	BD11-283C-1286	03	

LIST OF DRAWINGS

SL. NO.	DRG. NUMBER	SHEET	REVISION	DRG. TITLE
1.	BD11-283C-1286	01	03	FRONT COVER FOR 11KV, 2500A SPB.
2.	BD11-283C-1286	02	04	LIST OF DRAWINGS FOR 11KV, 2500A SPB.
3.	BD11-283C-1286	03	03	SINGLE LINE DIAGRAM FOR 11KV, 2500A SPB.
4.	BD11-283C-1286	04	02	TECHNICAL DATA SHEET FOR PT, LA, SC, NGT & LOADING RESISTOR FOR 11KV, 2500A SPB.
5.	BD11-283C-1286	05	04	LAYOUT DRAWING FOR 11KV, 2500A SPB.
6.	BD11-283C-1286	06	04	LAYOUT DRAWING FOR 11KV, 2500A SPB.
7.	BD11-283C-1286	07	02	GA OF PTSP CUBICAL FOR 11KV, 2500A SPB.
8.	BD11-283C-1286	08	01	GA OF PTSP CUBICAL FOR 11KV, 2500A SPB.
9.	BD11-283C-1286	09	03	GENERAL ARRANGEMENT OF NG CUBICAL FOR 11KV, 2500A SPB.
10.	BD11-283C-1286	10	02	WIRING DIAGRAM OF CTs FOR 11KV, 2500A SPB
11.	BD11-283C-1286	11	02	WIRING DIAGRAM OF CTs & PTs FOR TMM FOR 11KV, 2500A SPB
12.	BD11-283C-1286	12	02	WIRING DIAGRAM OF PTs FOR 11KV, 2500A SPB
13.	BD11-283C-1286	13	01	WIRING DIAGRAM OF NG CUBICAL FOR 11KV, 2500A SPB
14.	BD11-283C-1286	14	03	GENERATOR TERMINATION FOR 11KV, 2500A SPB.
15.	BD11-283C-1286	15	03	CONNECTION DETAIL AT HT PANEL FOR 11KV, 2500A SPB.
16.	BD11-283C-1286	16	02	CONNECTION DETAIL AT PTSP CUBICAL FOR 11KV, 2500A SPB.
17.	BD11-283C-1286	17	02	CONNECTION DRAWING ND CUBICAL FOR 11KV, 100A SPB.
18.	BD11-283C-1286	18	02	BUSBAR SIZING, INSULATOR SPAN & THERMEL WITHSTAND CAPABILITY CALCULATION 11KV, 2500A SPB.
19.	BD11-283C-1286	19	02	TYPICAL CROSS SECTIONAL, ACCESS DOOR, ENCLOSURE FLANGE & RUBBER BELLOW FOR 11KV, 2500A SPB.
20.	BD11-283C-1286	20	02	TYPICAL DETAIL OF SUPPORT INSULATOR, INSULATOR ASSEMBLY, EPOXY SEAL OF BUSHING, BUSBAR RIGID & EXPANSION JOINT, & SPACE HEATER WIRING DIAGRAM FOR 11KV, 2500A SPB.
21.	BD11-283C-1286	21	02	WALL/FLOOR FRAME ASSEMBLY DETAIL FOR 11KV, 2500A SPB.
22.	BD11-283C-1286	22	03	DETAIL OF SUPPORTING STRUCTURE FOR 11KV, 2500A SPB.
23.	BD11-283C-1286	23	03	DETAIL OF SUPPORTING STRUCTURE FOR 11KV, 2500A SPB.

REV/NO	DESCRIPTION OF CHANGE	DATE	SIGN.	DRN.	DATE	CUSTOMER :	PROJECT :	DRG. TITLE:	DRG. NO.	SHEET NO.
04	AS BUILT DRAWING	18.12.12	MOHIT	ANAND	11.05.12	M/s BHARAT HEAVY ELECTRICALS LTD, HYDERABAD.	CONSULTANT : AVANT-GARDE ENGINEERS AND CONSULTANTS (P) LTD. CHENNAI	68, INDUSTRIAL DEVELOPMENT COLONY, GURGAON--122001	BD11-283	02
03	DRAWING REVISED AS PER CUSTOMER COMMENTS ON DED-17.12.12	17.12.12	ANAND	CHD.	ANAND					
02	DRAWING REVISED AS PER CUSTOMER COMMENTS/INPUT RECEIVED ON 23.06.12	26.06.12	ANAND							
01	DRAWING REVISED AS PER CUSTOMER COMMENTS/INPUT RECEIVED ON 15&23.05.12	12.06.12	ANAND	APPD.	V.PAL					
REV/NO	DESCRIPTION OF CHANGE	DATE	SIGN.							

AS BUILT DRAWING

JOB NO.


BD11-283

SHEET NO.

02

REV. NO.

04



SPACEAGE SWITCHGEARS LIMITED

68, INDUSTRIAL DEVELOPMENT COLONY,
GURGAON--122001

TECHNICAL DATA SHEET

TYPE OF BUSDUCT..... : SEGREGATED PHASE BUSDUCT
RATED VOLTAGE..... : 11KV
RATED CONTINUOUS CURRENT (MAIN)..... : 2500A
RATED HIGHEST SYSTEM VOLTAGE..... : 12KV
AMBIENT TEMP..... : 50°C
MAX. BUSBAR TEMPERATURE..... : 90°C
MAX. ENCLOSURE TEMPERATURE..... : 70°C
RATED CONTINUOUS CURRENT (THE DUCT)..... : 250 A
FREQUENCY..... : 50 Hz
NO OF PHASE..... : 3 POLE
FAULT CURRENT AND DURATION..... : 40 KA rms SYM. FOR 3 SECONDS, 102 KA PEAK
ENCLOSURE SIZE & MATERIAL..... : 1380X400X3 THK. AL ALLOY
BARRIER MATERIAL AND SIZE..... : 3 THK. AL ALLOY
BUSBAR SIZE AND MATERIAL..... : 2 Nos. 101.6X41.83X6.68 THK. AL ALLOY CHANNEL
BUSBAR JOINTS..... : PLAIN WITH NO-OXIDE GREASE.
TYPE OF INSULATOR..... : PORCELAIN
BASIC INSULATION LEVEL:
 (a. ONE MINUTE POWER FREQUENCY..... : 28 KV RMS/ 10KV RMS.
 (b. IMPULSE WITHSTAND VOLTAGE..... : 75 KV PEAK/ 60KV PEAK
GROUND BUS..... : 2-50X10 THK. AL
PAINTING-
ENCLOSURE INTERIOR & BUSBAR..... : MAT BLACK
ENCLOSURE EXTERIOR..... : EPOXY SPRAY PAINT OF SHADE RAL-7032.
DEGREE OF PROTECTION..... : IP55
APPLICABLE STANDARD..... : IS- 8084
ELECTRICAL CLEARANCE-
PHASE TO PHASE..... : 127 mm
PHASE TO EARTH..... : 100 mm
CURRENT TRANSFORMER-
 1. MAKE..... : INSTARNS/KAPPY/KALPA/PRAGATI/AE/ECS
 2. TYPE..... : EPOXY CAST, RING TYPE DRY TYPE
 (PADSTAL MOUNTING)
 3. REFERENCE STANDARD..... : IS - 2705 / EC-60044-1
 4. VOLTAGE CLASS..... : 12KV FOR CT - 1 TO 18, 19, 20, 21,24, 25, 26
 250A FOR CT - 22 & 23
 5. INSULATION CLASS..... : B
 6. TEMP. RISE OVER AN AMBIENT..... : AS PER INSULATION CLASS B
AT RATED PRIMARY CURRENT
 7. MOMENTARY RATING..... : 102 KAP FOR CT-1 TO 18, 19, 20, 21, 22, 23, 24, 25, 26
 40KA FOR 3 SEC FOR CT-1 TO 18, 19, 20, 21, 24, 25, 26
 25KA FOR 1 SEC FOR CT-22 & 23
 9. ONE MINUTE POWER FREQUENCY..... : 28KV (RMS) FOR CT-1 TO 18, 19, 20, 21, 24, 25, 26
 WITHSTAND VOLTAGE..... : 3KV (RMS) FOR CT-22 & 23
 10. IMPULSE WITHSTAND VOLTAGE..... : 75KV (PEAK) FOR CT-1 TO 18, 19, 20, 21, 22, 23, 24, 25, 26
 11. NO OF PHASES..... : SINGLE
 12. RATED FREQUENCY..... : 50 Hz

POTENTIAL TRANSFORMER-

1. MAKE..... : INSTARNS/KAPPY/KALPA/PRAGATI/AE/ECS
 2. TYPE..... : INDOOR, DRY TYPE, SINGLE PHASE EPOXY CAST
 3. REFERENCE STANDARD..... : IS - 3156 / EC-60044-2
 4. INSULATION CLASS..... : B¹
 5. OVER VOLTAGE FACTOR
 i) CONTINUOUS..... : 1.2
 ii) 30 SECOND..... : 1.9
 6. MAX. TEMP. RISE ABOVE 50°C AMBIENT : AS PER INSULATION CLASS B¹
 7. WINDING CONNECTION PRIMARY/SECONDARY : STAR WITH GROUNDED
 8. INSULATION LEVEL..... : 12.28/75KV
 9. WINDING CONNECTION PRIMARY/SECONDARY : STAR WITH GROUNDED
 10. RATED SHORT TIME CURRENT..... : 40KA FOR 3 SEC
 11. RATED FREQUENCY..... : 50 Hz
LIGHTNING ARRESTOR-
 1. NAME OF MANUFACTURER..... : IGE/ELPRO
 2. TYPE..... : METAL OXIDE STATION CLASS HERMETICALLY SEALED (GAPLESS)
 3. SERVICE..... : INDOOR
 4. REFERENCE STANDARD..... : IS-3070/IEC-99.4
 5. RATED VOLTAGE..... : 12KV
 6. NOMINAL DISCHARGE CURRENT..... : 10KA
 7. POWER FREQUENCY WITHSTAND VOLTAGE.. : 35KV FOR 1 MIN FOR CASING
 8. QUANTITY..... : 03 NOS.

SURGE CAPACITOR-

1. NAME OF MANUFACTURER..... : MADHAV CAPACITORS/MS INSULATORS/PRAGATI/POWERGEAR
 2. TYPE..... : OIL TYPE
 3. REFERENCE STANDARD..... : IS-11548
 4. RATED VOLTAGE..... : 18KV
 5. RATED FREQUENCY..... : 50Hz
 6. RATED CAPACITANCE..... : 0.25 MICRO FARADS
 7. POWER FREQUENCY WITHSTAND VOLTAGE.. : 35 KV
 8. IMPULSE W/S VOLTAGE..... : 75 KV (PEAK)
 9. QUANTITY..... : 03 NOS.

LOADING RESISTOR-


1. NAME OF MANUFACTURER..... : BHARTI INDUSTRIES/RESITECH/RSJ/SR MARKHEDE Engg./LAKSHMAN ELEC.
 2. TYPE..... : PUNCHED STAINLESS STEEL/
 GRID TYPE
 3. REFERENCE STANDARD..... : IEEE : 32
 4. VOLTAGE LEVEL..... : 12 KV
 5. CURRENT RATING..... : 100A FOR 30 SEC
 6. CONTINUOUS CURRENT RATING..... : 15A
 7. RESISTANCE VALUE..... : 63.5 OHMS
 8. AMBIENT TEMPERATURE..... : 50°C
 9. SERVICE CONDITION..... : INDOOR/NATURAL AIR COOLED
 10. MAX. TEMP. RISE WITH 30 SEC. CURRENT RATING..... : 300°C
 11. QUANTITY..... : 01 NO.


ISOLATOR-

OFF LOAD & MOTORIZED ISOLATOR
 100A, 2NO, 2NC, DREISHER PANICKAR/SIEMENS/NGE/A- BOND

REFERENCE DRGS-

(M/s BHEL)
 1. LAYOUT PLAN OF TURBO GENERATOR, DRG NO.-113912313224-REV-02
 2. KEY DIAGRAM FOR MEASURING & PROTECTION DRG NO.-1561010131498-REV-04.

		DRN.	DATE	CUSTOMER :	 SPACEAGE SWITCHGEARS LIMITED 68, INDUSTRIAL DEVELOPMENT COLONY, GURGAON-122001	DRG. TITLE: TECHNICAL DATA SHEET 11KV, 2500A SPB.	AS BUILT DRAWING
		ANAND	11.05.12	M/s BHARAT HEAVY ELECTRICALS LTD. HYDERABAD.			JOB NO. BD11-283
		CHD.	ANAND	CONSULTANT :	PROJECT : LOKMANGAL MAUJI INDUSTRIES LTD. 1 X 30 MW STG, OSMANABAD, MAHARASHTRA	DRG. NO. BD11-283C-1286	SHEET NO.
02	AS BUILT DRAWING		18.12.12	MOHIT			AVANT-GARDE ENGINEERS AND CONSULTANTS (P) LTD. CHENNAI
01	DRAWING REVISED AS PER CUSTOMER COMMENTS/INPUT RECEIVED ON 15&23.05.12	ANAND	12.06.12	ANAND	V.PAL		
REV.NO.	DESCRIPTION OF CHANGE	DATE	SIGN.				

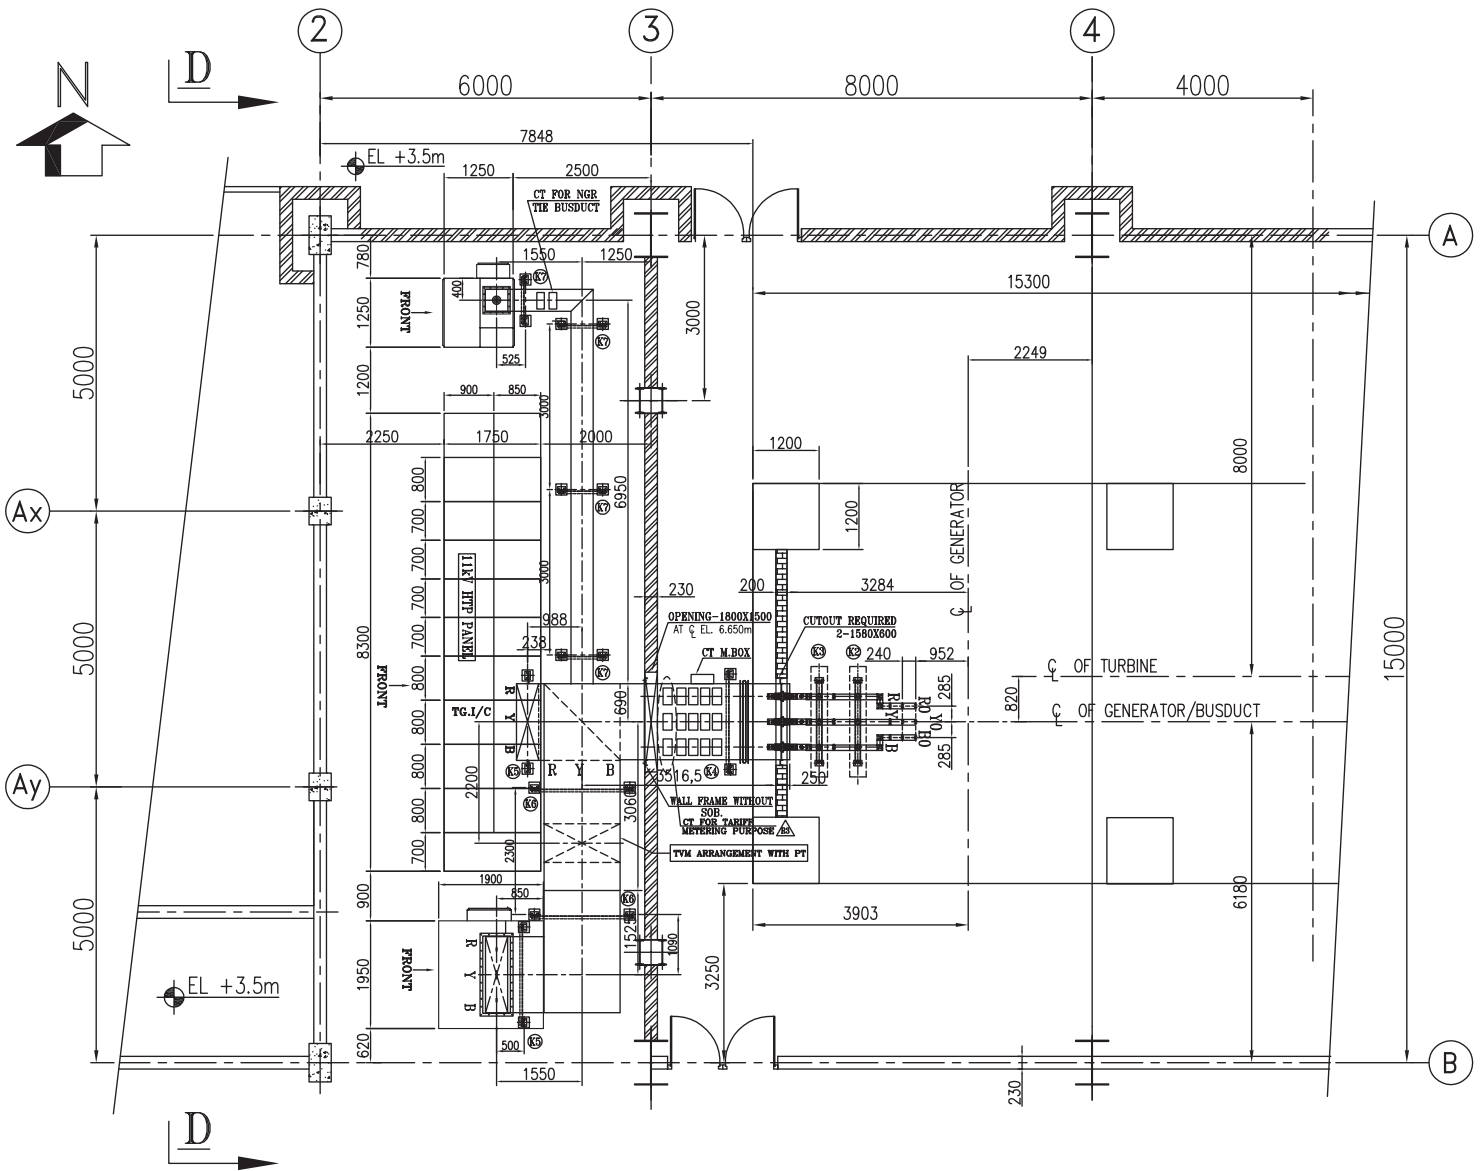

**TG BUILDING OPERATING FLOOR PLAN AT
EL. +10.000m LEVEL**

GEN. NOTES:-

1. ALL DIMENSIONS ARE IN mm UNLESS OTHERWISE SPECIFIED.

PAINTING:-

- (i) ENCLOSURE INTERIOR - MATT BLACK
- (ii) ENCLOSURE EXTERIOR - EPOXY SPRAY PAINT OF SHADE RAL-7032.

M/S BHARAT HEAVY ELECTRICALS LIMITED

- 1. BUSDUCT LAYOUT REFER DRG. NO.-
1-29179-900-0466 REV-04. (SHEET 1 OF 05)
- 2. MACHINERY ARRANGEMENT AND FOUNDATION
(1-313-00-83235) SHEET NO. 1 TO 5.) REV. 05
- 3. TERMINAL ARRANGEMENT OF GENERATOR
(1-135-08-31438/R1)

M/s SPACEAGE SWITCHGEARS LTD.

- 1. G.A. DRG. OF LAVT CUBICLE.
BD11-283C-1286 REV-01.
- 2. G.A. DRG. OF NG CUBICLE.
BD11-283C-1286 REV-01.


AS BUILT DRAWING

REV.NO	DESCRIPTION OF CHANGE	DATE	SIGN.	DRN.	DATE	CUSTOMER :	JOB NO.
				ANAND	11.05.12	M/s BHARAT HEAVY ELECTRICALS LTD. HYDERABAD.	BD11-283
04	AS BUILT DRAWING	18.12.12	MOHIT	CHD.	ANAND	CONSULTANT :	SHEET NO.
03	DRAWING REVISED AS PER CUSTOMER COMMENTS ON DED.-17.12.12	17.12.12	ANAND			AVANT-GARDE ENGINEERS AND CONSULTANTS (P) LTD. CHENNAI	05
02	DRAWING REVISED AS PER CUSTOMER COMMENTS/INPUT RECEIVED ON 23.06.12	26.06.12	ANAND	APPD.	V.PAL	PROJECT :	DRG.NO.
01	DRAWING REVISED AS PER CUSTOMER COMMENTS/INPUT RECEIVED ON 15&23.05.12	12.06.12	ANAND			LOKMANGAL MAULI INDUSTRIES LTD. 1 X 30 MW STG, DSMANABAD, MAHARASHTRA	REV. NO.
						DRG. TITLE: LAYOUT DRAWING PLAN FOR 11KV,2500A SPB.	BD11-283C-1286
						68, INDUSTRIAL DEVELOPMENT COLONY, GURGAON-122001	04



SPACEAGE SWITCHGEARS LIMITED




68, INDUSTRIAL DEVELOPMENT COLONY, GURGAON-122001

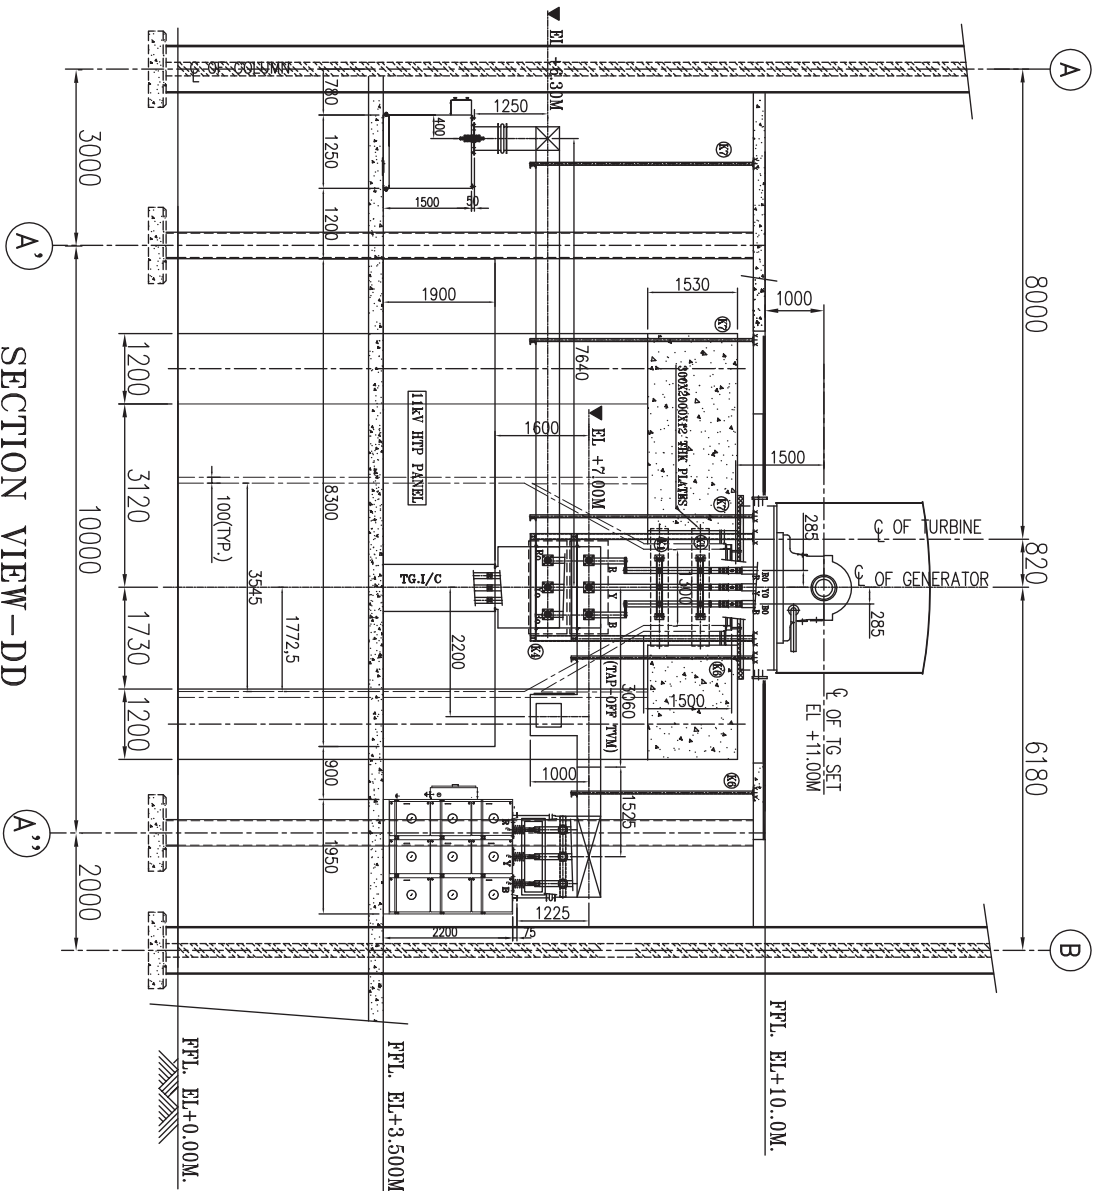

S.NO.	DESCRIPTION	QTY.
1.	OPEN BUSBAR(2-100X10) FOR 11kV, 2500A(11kV GRADE) WITH PVC SLEEVED	28.70M.
2.	11kV, 2500A SPB SUITABLE FOR 40KA FOR 3SEC. ON PHASE SIDE FROM GEN. TO BREAKER PANEL	6.355M.
3a.	11kV, 250A, SUITABLE FOR 40KA FOR 3SEC. TAP-OFF BUSDUCT FOR PTSP CUBICLE.	4.30M.
3b.	11kV, 250A, SUITABLE FOR 40KA FOR 3SEC. TAP-OFF BUSDUCT FOR TWM ARRANGEMENT.	4.08M.
4.	90 DEG. BEND (HORIZ./VERTICAL) FOR PHASE SIDE	7NOS.
5.	11kV, 2500A SPB SUITABLE FOR 40KA FOR 3SEC. ON NEUTRAL SIDE FROM GEN. N. TO NG CUBICLE.	4.446M.
6.	90 DEG. BEND (HORIZ./VERTICAL) FOR NEUTRAL SIDE	3NOS.
7.	11kV, 250A SINGLE PHASE TAP-OFF BUSDUCT FOR CONNECTION TO NG ON NEUTRAL SIDE	9.76M.
8.	SEAL OF BUSHING AT PTSP CUBICLE, NG CUBICLE TOP	3+1=4NOS.
9.	WALL FRAME ASSEMBLY WITH 03NOS. SEAL OF BUSHING AT GEN. WALL PHASE AND NAUTRAL SIDE	03+03=6NOS.
10.	CTS AS PER WIRING DIAGRAM SH#3&4	20 NOS
11.	LAPT CUBICLE AS PER SPEC.	1NO.
12.	LIGHTNING ARRESTORS HOUSED IN LAPT CUBICLE	3NOS.
13.	SURGE CAPACITORS HOUSED IN LAPT CUBICLE	3NOS.
14.	NGE CUBICLE CONTAINING NGR ANGR CUBICLE SHALL BE PROVIDED WITH SUITABLE FLANGE FOR BUSDUCT TERMINATION.	1NO.
15.	NGR SHALL BE PROVIDED WITH OFF-LOAD MOTORIZED ISOLATOR	1NO.
16.	SUPPORT STEEL STRUCTURE (HOT DIP GALVANIZED)	1.212MT
17.	SILICA GEL BREATHERS	06 NOS.
18.	COPPER FLEXIBLES AS REQUIRED AT GENERATOR TERMINALS, & SEAL-OFF BUSHING AT GEN. FOR LINE SIDE BUSDUCT & NEU. SIDE BUSDUCT, PTSP CUBICLE, NG CUBICLE & BREAKER END	4+1+1+1=7SETS
19.	CU. FLEXIBLES AT GEN. AIR DUCT WALL PHASE & NEUTRAL SID.	1+1 SETS
20.	HARDWARE FOR BUSBAR Codmium Zn PLATED & FOR ENCLOSURE ETC. MS Zn PLATED	AS REQUIRED
21.	EPDM EXPANSION BELLOW AT GEN. PHASE & NEUTRAL	2NOS.
22.	EPDM EXPANSION BELLOW AT PTSP CUBICLE	1NO.
23.	EPDM EXPANSION BELLOW AT NG CUBICLE	1NO.
24.	EPDM EXPANSION BELLOW AT BREAKER	1NO.
25.	CABLE GAND SUITABLE FOR 50X2.55q,mm AND 100X2.55q,mm CABLES 75+75=150NOS.	3NOS.
26.	SINGLE PHASE CTS FOR TARIFF METERING	3NOS.
27.	SINGLE PHASE PT.s FOR TARIFF METERING	3NOS.
28.	SHORTING ARRANGEMENT ON PHASE SIDE	1NO.
29.	WALL FRAME ASSEMBLY WITHOUT SOB AT GT BUILDING	01NO.
30.	SPACE HEATHER MARSHALLING BOX.	3NOS.
31.	CT.s MARSHALLING BOX.	4NOS.

REVNO	DESCRIPTION OF CHANGE	DATE	SIGN.	APPD.	V/PAL	PROJECT :	DRG. TITLE:	DRG.IND.	REV. NO.	
04	AS BUILT DRAWING	18.12.12	MDHIT	ANAND	ANAND	CUSTOMER : M/s BHARAT HEAVY ELECTRICALS LTD. HYDERABAD. CONSULTANT : AVANT-GARDE ENGINEERS AND CONSULTANTS (P) LTD. CHEMMAI PROJECT : LOKKANGAL MAULI INDUSTRIES LTD. 1 X 30 MW STG, DSMANABAD, MAHARASHTRA	68, INDUSTRIAL DEVELOPMENT COLONY, GURGAON-122001 SPACEGE SWITCHGEARS LIMITED	BD11-283	SHEET NO.	
03	DRAWING REVISED AS PER CUSTOMER COMMENTS ON DED-17.12.12	17.12.12	ANAND	ANAND	CHD.			11.05.12	DRG.IND.	06
02	DRAWING REVISED AS PER CUSTOMER COMMENTS/INPUT RECEIVED ON 23.05.12	26.06.12	ANAND	ANAND	CHD.				DRG.IND.	
01	DRAWING REVISED AS PER CUSTOMER COMMENTS/INPUT RECEIVED ON 15.02.05.12	12.06.12	ANAND	ANAND	APPD.				DRG.IND.	
REVNO	DESCRIPTION OF CHANGE	DATE <td>SIGN. <td>APPD. <td>V/PAL <td></td> <td>LAYOUT DRAWING PLAN FOR 11kV,2500A SPB</td> <td>BD11-283C-1286</td> <td>04</td> </td></td></td>	SIGN. <td>APPD. <td>V/PAL <td></td> <td>LAYOUT DRAWING PLAN FOR 11kV,2500A SPB</td> <td>BD11-283C-1286</td> <td>04</td> </td></td>	APPD. <td>V/PAL <td></td> <td>LAYOUT DRAWING PLAN FOR 11kV,2500A SPB</td> <td>BD11-283C-1286</td> <td>04</td> </td>	V/PAL <td></td> <td>LAYOUT DRAWING PLAN FOR 11kV,2500A SPB</td> <td>BD11-283C-1286</td> <td>04</td>		LAYOUT DRAWING PLAN FOR 11kV,2500A SPB	BD11-283C-1286	04	

AS BUILT DRAWING

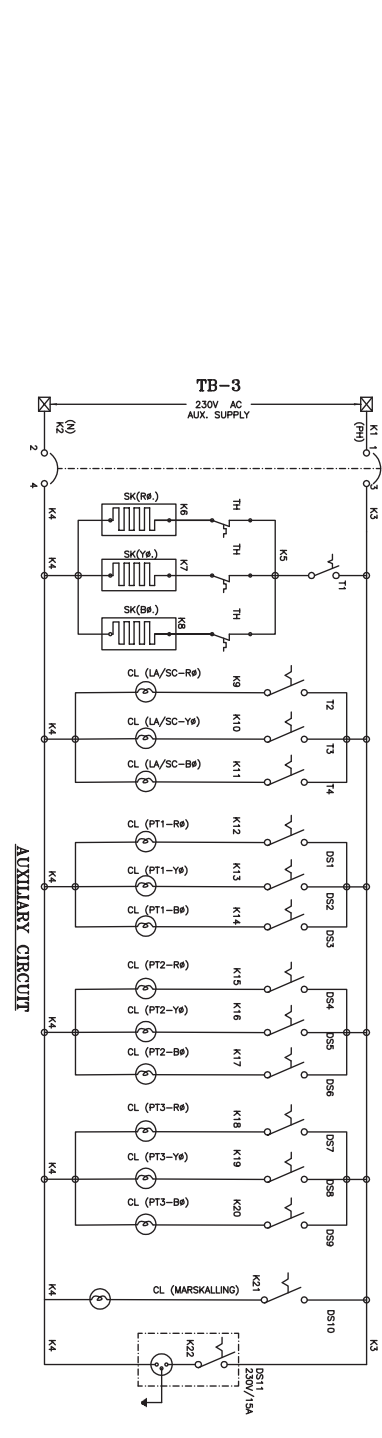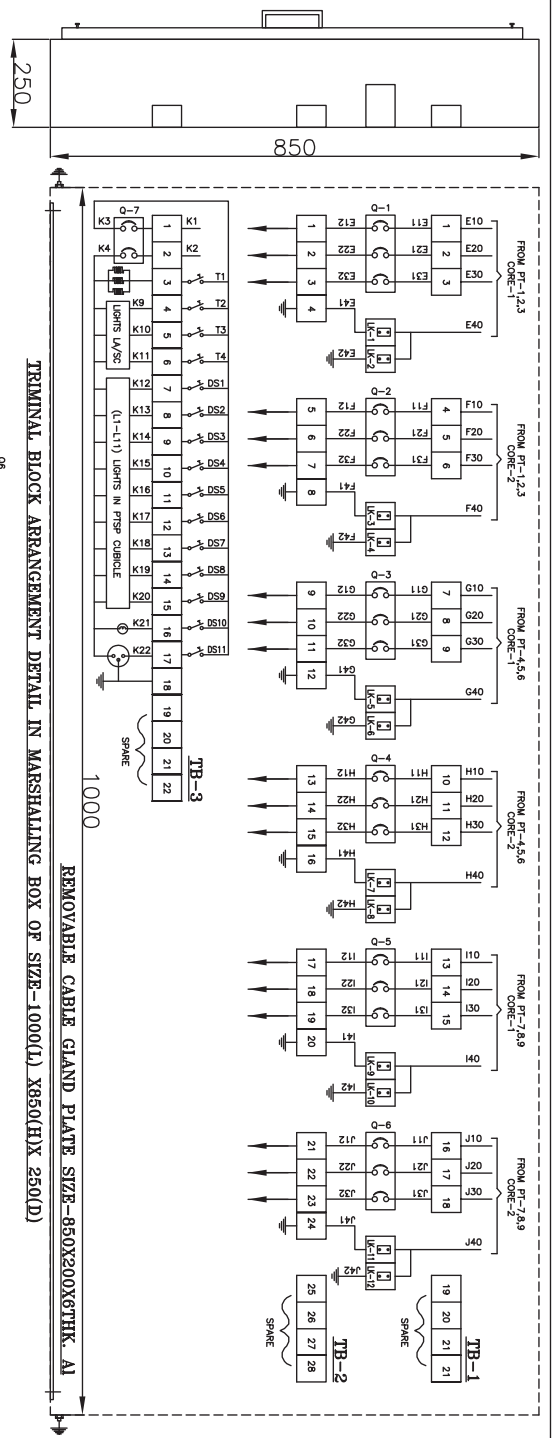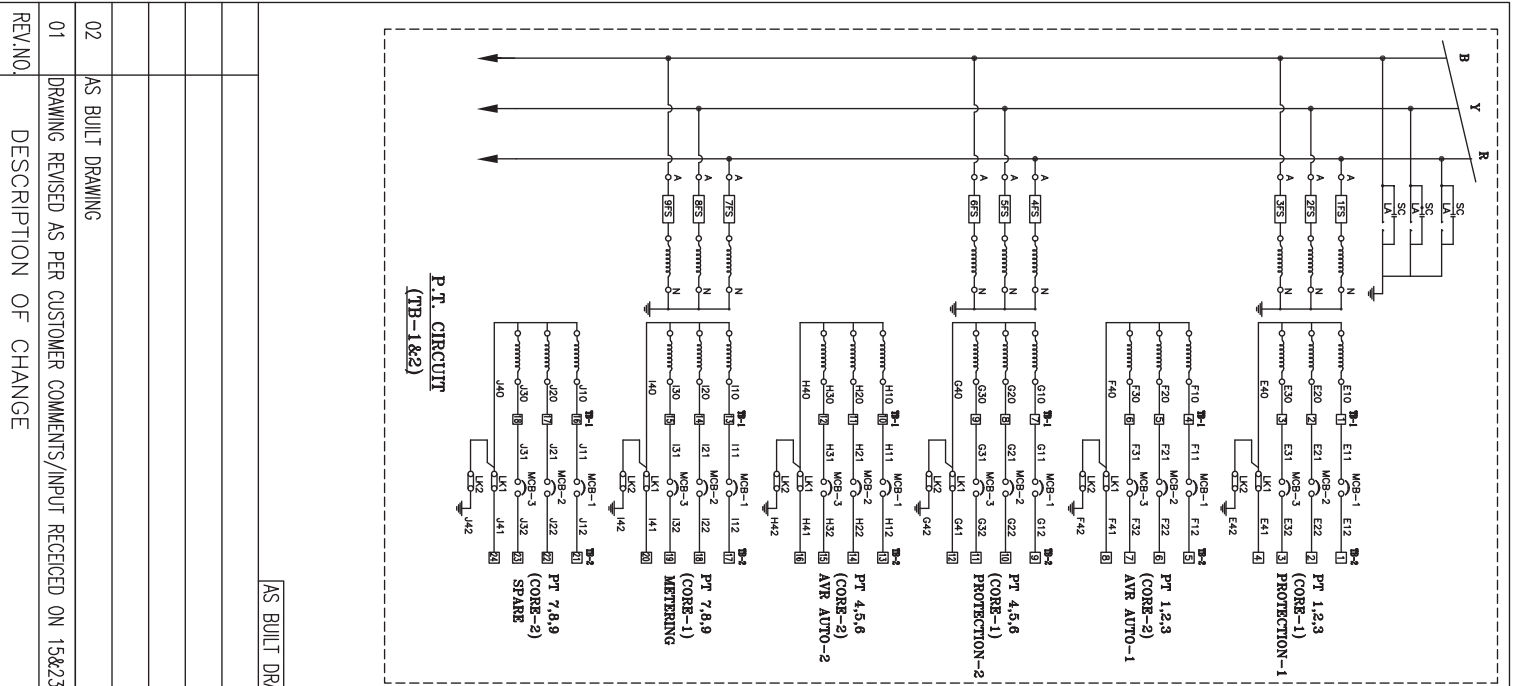


TECHNICAL PARTICULARS OF POTENTIAL TRANSFORMER			
S.NO	PT REF.	RATIO & BURDEN	PURPOSE CONNECTION LOCATION
01	1,2,3	CORE-1: 11kV / 110V 3P, 30VA CORE-2: 11kV / 110V 0.2, 30VA CORE-3: 11kV / 110V 0.2, 30VA	PROTECTION-1 AVR AUTO-1 PROTECTION-2
02	4,5,6	CORE-1: 11kV / 110V 3P, 30VA CORE-2: 11kV / 110V 0.2, 30VA CORE-3: 11kV / 110V 0.2, 75VA	PTSP CUBICLE PTSP CUBICLE PTSP CUBICLE
03	7,8,9	CORE-2: 11kV / 110V 3P, 30VA CORE-3: 11kV / 110V 3P, 30VA	SPARE


SL NO.	DESCRIPTION	QTY.	MAKE
Q1-6	MINIATURE CIRCUIT BREAKER RATING: 6A, SP 16ADP	06 NOS.	MDS/MG
Q7	DOOR SWITCH, 1 POLE, 5A	10 NOS.	KANGEE ANCHOR
DS1-10	TOGGLE SWITCH, 1 POLE, 15A	1 NO.	KANGEE ANCHOR
TT-4	THERMOSTAT, RANGE : 30-90° C	4 NOS.	KANGEE ANCO
SH	SPACE HEATER, 80W, 230V AC	3 NOS.	REPOIED
SO	3 PIN SOCKET WITH SWITCH RATING : 230VAC AC, 15A	3 NOS.	ANCHOR PHILIPS
CL	CFL WITH HOLDER , 18W, 230V AC	13 NOS.	PHILIPS
TB	TERMINAL BLOCK, STUD TYPE : CATD M4 (TB-1,2,3)	21+28+22 NOS.	ELMEX

BILL OF MATERIAL	
CUSTOMER :	M/s BHARAT HEAVY ELECTRICALS LTD. HYDERABAD.
CONSULTANT :	AVANT-GARDE ENGINEERS AND CONSULTANTS (P) LTD. CHENNAI
PROJECT :	LOKANGAL MAULI INDUSTRIES LTD. 1 X 30 MM STG. OSMANABAD, MAHARASHTRA

REVNO.	DESCRIPTION OF CHANGE	DATE	SIGN.	APPD.	V.PAL
01	DRAWING REVISED AS PER CUSTOMER COMMENTS/INPUT RECEIVED ON 15&23.05.12	12.06.12	ANAND		
02	AS BUILT DRAWING	18.12.12	MOHIT		

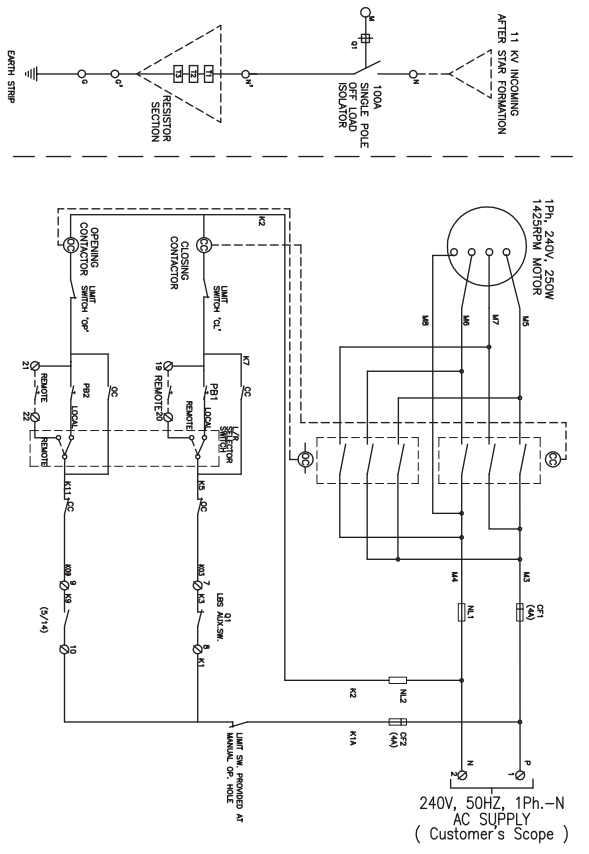


SCHEMATIC OF ISOLATOR

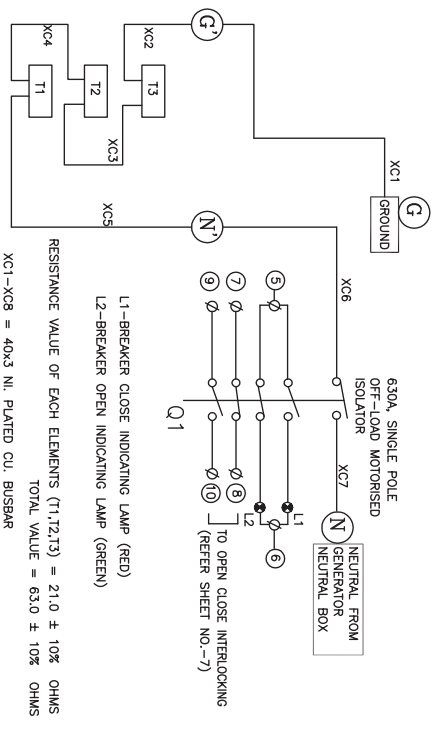


SCHEMATIC / CONNECTION DIAGRAM FOR NEUTRAL GROUNDING RESISTOR


L1-BREAKER CLOSE INDICATING LAMP (RED)
 L2-BREAKER OPEN INDICATING LAMP (GREEN)
 RESISTANCE VALUE OF EACH ELEMENTS (T1,T2,T3) = 21.0 ± 10% OHMS
 TOTAL VALUE = 63.0 ± 10% OHMS
 XC1-XC8 = 40x3 NI. PLATED CU. BUSBAR

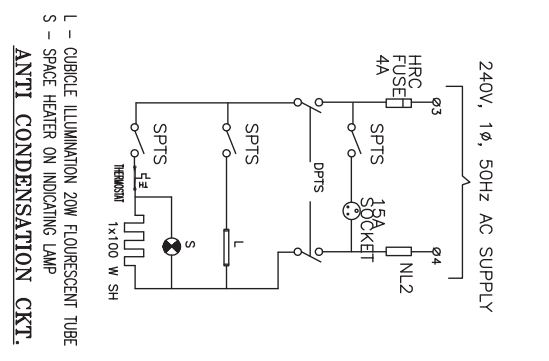


ANTI CONDENSATION CKT.
 L - CUBICLE ILLUMINATION 20W FLUORESCENT TUBE
 S - SPACE HEATER ON INDICATING LAMP

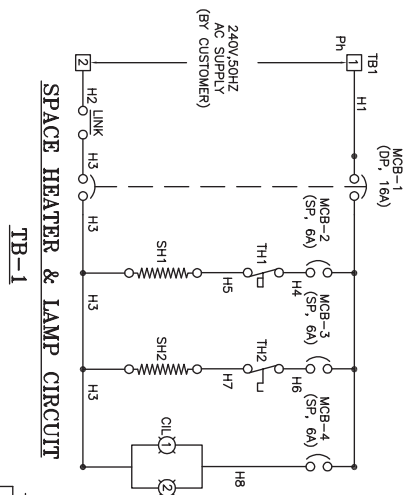

SPACE HEATER & LAMP CIRCUIT TB-1

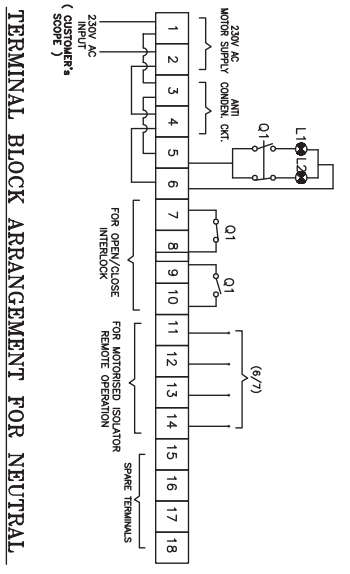

TERMINAL BLOCK ARRANGEMENT FOR NEUTRAL

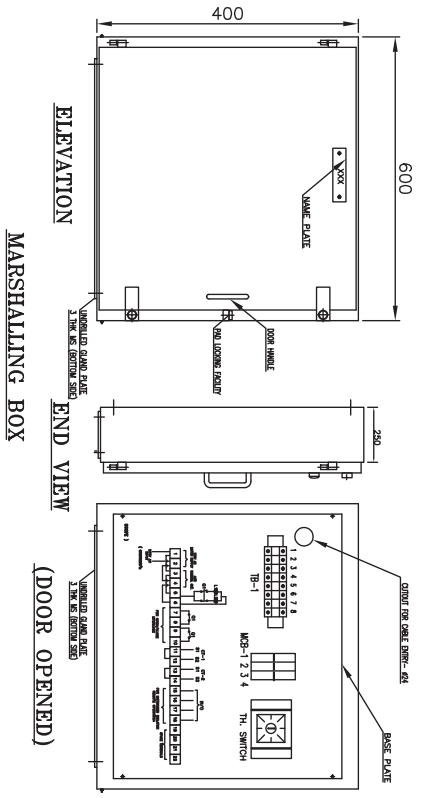




ELEVATION MARSHALLING BOX (DOOR OPENED)

BILL OF MATERIAL

S. NO.	REF. NO.	DESCRIPTION	QTY./UNIT	MAKE	TYPE
8	TB-1	TERMINAL BLOCK STUD TYPE	08+21 NOS.	ELMEX	CAT M4
7	MCB-2,3,4	MINIATURE CIRCUIT BREAKER 240V, AC, SP, 6A	3 NOS.	STANDARD/INDOKOPP	--
6	MCB-1	MINIATURE CIRCUIT BREAKER 240V, AC, DP, 16A	1 NO.	STANDARD/INDOKOPP	--
5	CFL	CFL 240V AC, 15W	2 NOS.	CGI/BAJAJ	--
4	TH	THERMOSTAT 30-110°C, 240V AC	2 NOS.	ANCO	--
3	SH	SPACE HEATER	2 NOS.	REPUTED	--

AS BUILT DRAWING

01	AS BUILT DRAWING	18.12.12	MDHIT	APPD.	V.PAL	CUSTOMER : M/S BHARAT HEAVY ELECTRICALS LTD. HYDERABAD.	CONSULTANT : AVANT-GARDE ENGINEERS AND CONSULTANTS (P) LTD. CHENNAI	PROJECT : LOKMANGAL MAULI INDUSTRIES LTD. 1 X 30 MW STG, DSMABAD, MAHARASHTRA	DRG. TITLE : WIRING DIAGRAM OF NGTR CUBICLE FOR 11 KV, 2500A SPB.	DRG. NO. : BD11-283C-1286	REV. NO. : 01
REVND	DESCRIPTION OF CHANGE	DATE	SIGN.								

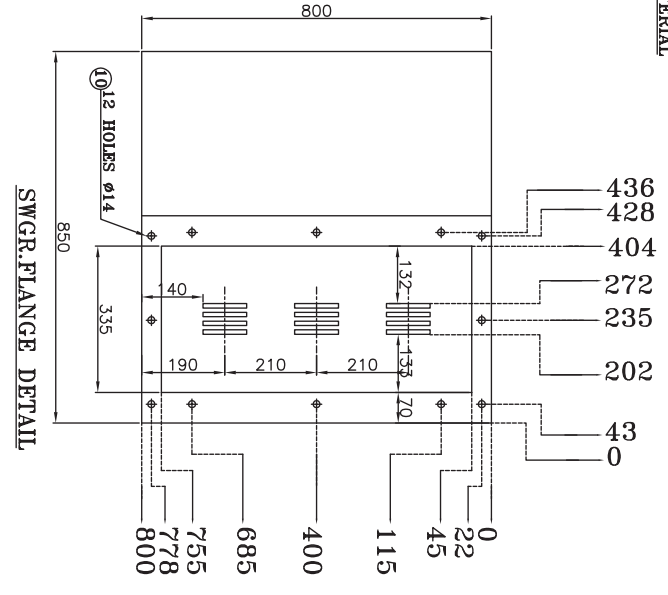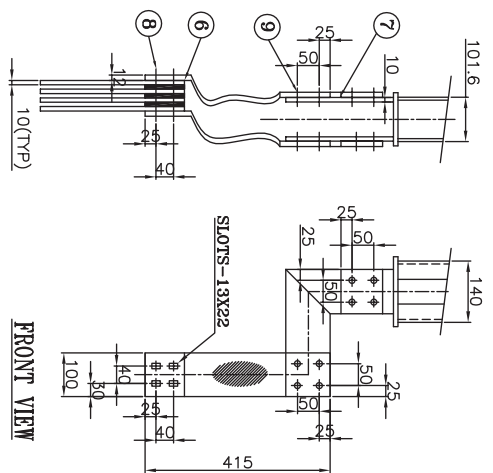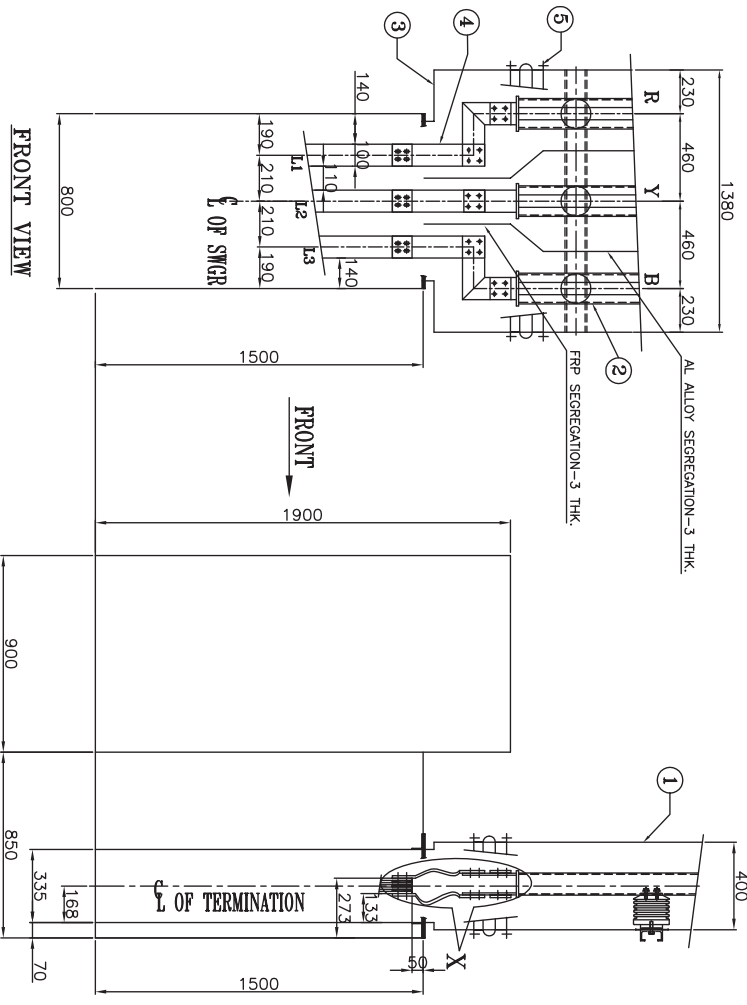

SL. NO	DESCRIPTION	MATL.	QTY.	REMARKS
11.	SPACER:100X80X8 THK.	AI ALLOY	09 NOS.	
10.	BOLT M10X35+N+2PW+SW	MS GALVD.	12 NOS.	
9.	BOLT M12X50+N+2PW+SW	CAD Zn PLATED	24 NOS.	
8.	BOLT M12X120+N+2PW+SW	CAD Zn PLATED	12 NOS.	
7.	AI LINKS 101.6X12.7 THK.	AI ALLOY	-----	
6.	BI-METALLIC STRIP (100X90X1THK.-18 NOS)	AI/CU ALLOY	18+6 NOS.	
5.	RUBBER BELLOW (100X100X1 THK.-06 NOS)	EPDM	01 NO.	
4.	Cu LAMINATED FLEXIBLE -100X12 THK.	COPPER	06 NOS.	
3.	ADAPTOR BOX-3 THK.	AI ALLOY	01 NO.	
2.	BUSBAR-2-101.6X41.83X6.68 THK. CHANNEL	AI ALLOY	LOT	
1.	ENCLOSURE-1380X400X3 THK. SHEET	AI ALLOY	LOT	

BILL OF MATERIAL

GEN. NOTES:-
 ALL DIMENSIONS ARE IN mm UNLESS OTHERWISE SPECIFIED.
REFERENCE DRAWING NO.:M/s SIEMENS LTD.

1. GENERAL ARRANGEMENT
 REFER DRAWING NO. G71570-B5189-V003-A. SHEET NO.01 TO 03.
 2. TOP BUSDUCT IN CB CHAMBER 1SET WINDOW CT IN CC 4X100X100cu
 REFER DRAWING NO. 896-1339.9 SHEET NO. (01 OF 03.)





REVNO.	DESCRIPTION OF CHANGE	DATE	SIGN.	DRN.	DATE	CUSTOMER :	CONSULTANT :	PROJECT :	DRG. TITLE:	DRG. NO.	REV. NO.
03	AS BUILT DRAWING	18.12.12	MOHIT	CHD.	ANAND	M/s BHARAT HEAVY ELECTRICALS LTD. HYDERABAD.	AMANT-GARDE ENGINEERS AND CONSULTANTS (P) LTD. CHENNAI	68, INDUSTRIAL DEVELOPMENT COLONY, GURGAON-122001	TERMINAL DETAIL AT HT PANEL END FOR 11KV, 2500A SPB.	BD11-283C-1286	03
02	DRAWING REVISED AS PER CUSTOMER COMMENTS/INPUT RECEIVED ON 23.06.12	26.06.12	ANAND	ANAND	ANAND						15
01	DRAWING REVISED AS PER CUSTOMER COMMENTS/INPUT RECEIVED ON 15&23.05.12	12.06.12	ANAND	APPD.	V.PAL						

AS BUILT DRAWING

JOB NO.
BD11-283

SHEET NO.
15

SPACEGEAR SWITCHGEARS LIMITED
 68, INDUSTRIAL DEVELOPMENT COLONY, GURGAON-122001

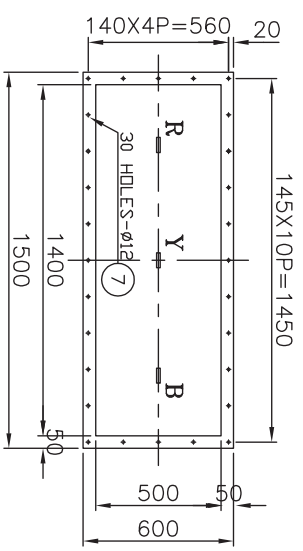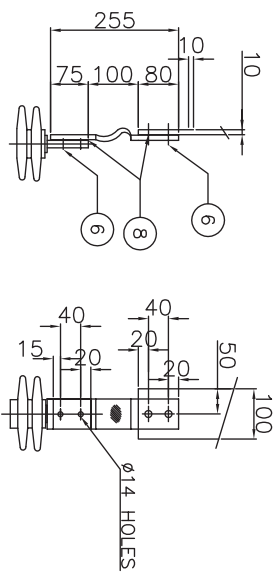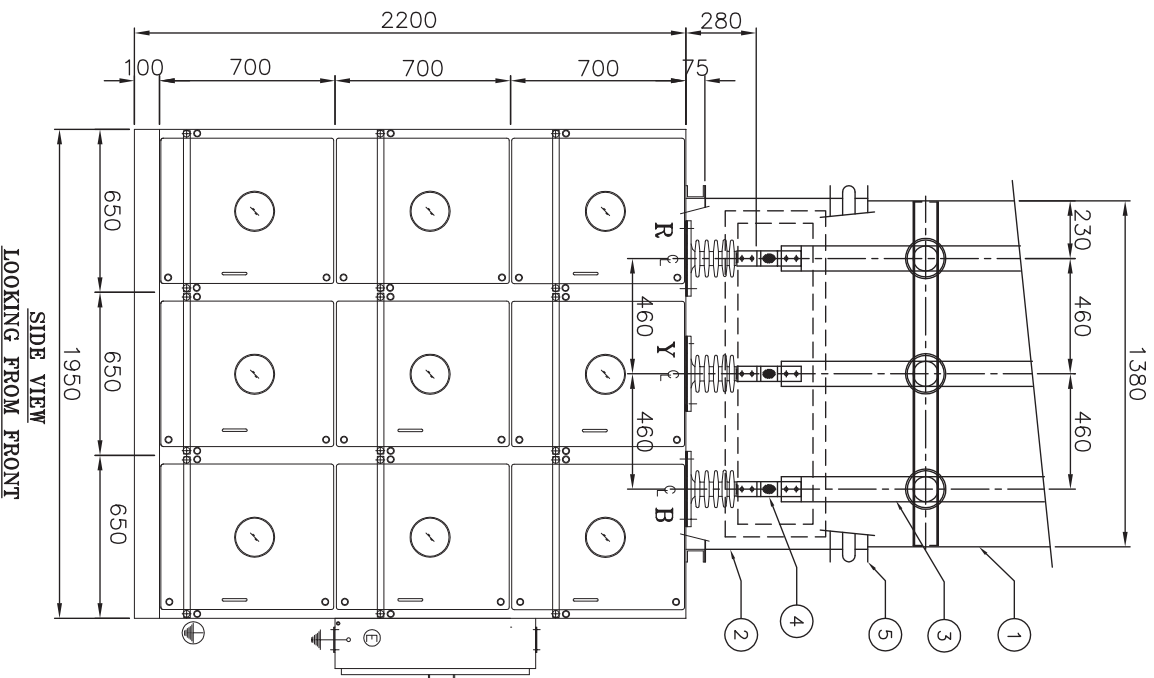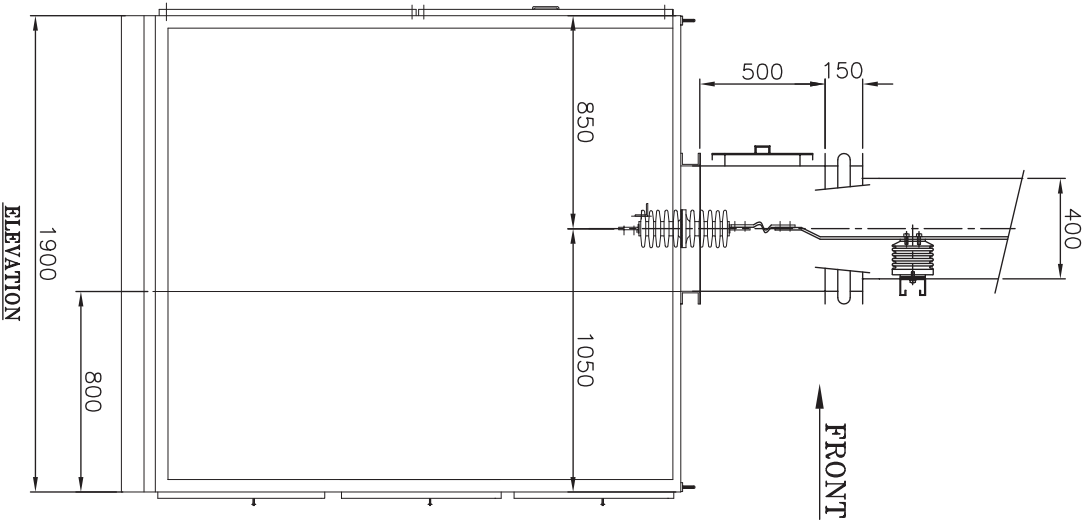

NOTES:-
1. ALL DIMENSIONS ARE IN mm UNLESS OTHERWISE SPECIFIED.


BILL OF MATERIALS

SL. NO.	DESCRIPTION	MATERIAL	QTY.	REMARKS
8.	BM STRIP 80x60, 1 THK.	Cu/Al	06 NOS	
7.	BOLT M10X35+N+2PW+SW	MS Zn PLATED	30 SETS	
6.	BOLT M12X50+N+2PW+SW	Cod Zn PLATED	12 SETS	
5.	RUBBER BELLOW	EPDM	01 NO.	
4.	LAMINATED FLEXIBLE-60x10 THK. 255 LONG	COPPER	03 NOS.	
3.	BUSBAR 100x10 THK. FLAT	Al ALLOY	03 NOS.	
2.	ADAPTOR BOX	Al ALLOY	01 NO.	
1.	ENCLOSURE SIZE-1380X400X3THK.	Al ALLOY	01 NO.	

02	AS BUILT DRAWING	18.12.12	MOHIT	ANAND	APPD.	V.PAL	PROJECT :	68, INDUSTRIAL DEVELOPMENT COLONY, GURGAON-122001	DRG. TITLE:	TERMINATION DETAIL AT PTSP CUBICLE	DRG. NO.	BD11-283C-1286	REV. NO.	02
01	DRAWING REVISED AS PER CUSTOMER COMMENTS/INPUT RECEIVED ON 15&23.05.12	12.06.12	ANAND	ANAND	CHD.	ANAND	CONSULTANT :	AVANT-GARDE ENGINEERS AND CONSULTANTS (P) LTD. CHENNAI	DRG. TITLE:	TERMINATION DETAIL AT PTSP CUBICLE	DRG. NO.	BD11-283C-1286	REV. NO.	02
REVAND	DESCRIPTION OF CHANGE	DATE	SIGN.				CUSTOMER :	M/s BHARAT HEAVY ELECTRICALS LTD. HYDERABAD.	DRG. TITLE:	TERMINATION DETAIL AT PTSP CUBICLE	DRG. NO.	BD11-283C-1286	REV. NO.	02

SPACEGE SWITCHGEARS LIMITED

JOB NO.	BD11-283
SHEET NO.	16

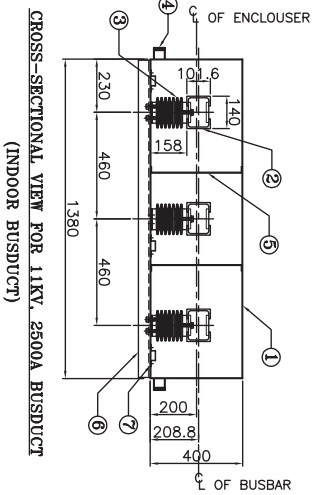


Sl. NO.	DESCRIPTION	MATL.	REMARKS
1.	ENCLOSURE- 1380X460X3 THK.	AL ALLOY	-----
2.	BUSBAR 2-101.6X41.63X6.86 THK. (BOX FORM)	AL ALLOY	2 NOS./PH
3.	INSULATOR- 150 HEIGHT	PORCELAIN	-----
4.	EARTH BUS- 2-50X10 THK.	Cu ALLOY	AS PER REQUIREMENT
5.	PHASE BARRIER-3mm THK.	AL ALLOY	-----
6.	AL ALLOY CHANNEL INSULATOR MOUNTING	AL ALLOY	-----
7.	SPACER HEATER	60W, 240V	-----







GEN. NOTES:-

1. ALL DIMENSIONS ARE IN mm UNLESS OTHERWISE SPECIFIED.
2. PAINTING:-
i) ENCLOSURE INTERIOR & BUSBARS :- MATT BLACK.
ii) ENCLOSURE EXTERIOR :- EPOXY SPRAY PAINT OF SHADE RAL7032.
3. ALL BOLTS, NUTS AND WASHERS SHALL BE MS ZN PLATED.

ITEM NO.	DESCRIPTION	SPECIFICATION	MATL.
1.	GASKET	15X10 THK.	EPDM
2.	HEX. BOLT	M8X35+1N+2PW+1SW	MS ZN PLATED

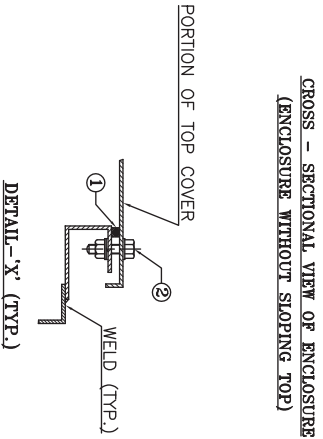

GROSS - SECTIONAL VIEW OF ENCLOSURE
(ENCLOSURE WITHOUT SLOPING TOP)

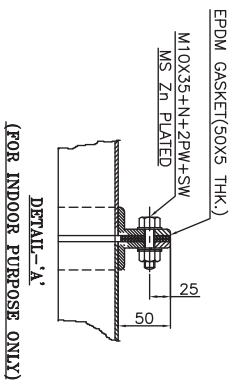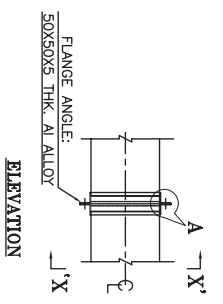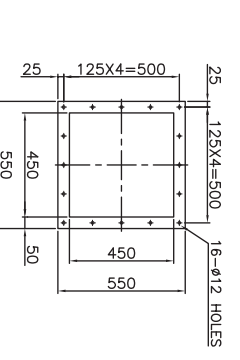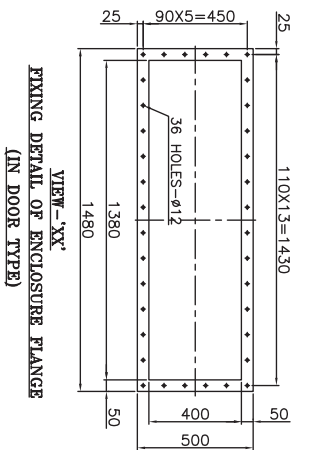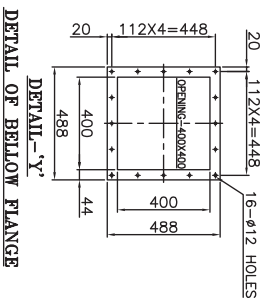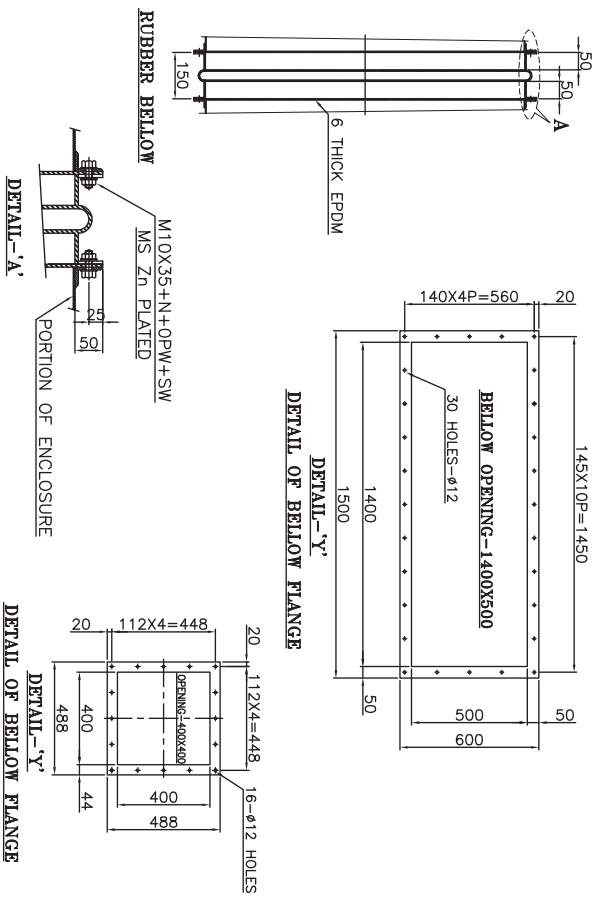

NOTES:-

1. ALL DIMENSIONS ARE IN mm UNLESS OTHERWISE SPECIFIED.
2. ALL BOLTS, NUTS AND WASHERS SHALL BE MS ZN PLATED.




REV.NO.	DESCRIPTION OF CHANGE	DATE	SIGN.	APPD.	DATE	CUSTOMER :	PROJECT :	DRG. TITLE:	DRG. NO.	REV. NO.
01	AS BUILT DRAWING	18.12.12	ANAND	APPD.	11.05.12	M/s BHARAT HEAVY ELECTRICALS LTD. HYDERABAD.	LOKANAGAL, MAULI INDUSTRIES LTD. (P) LTD. CHENNAI	68, INDUSTRIAL DEVELOPMENT COLONY, GURGAON-122001	BD11-283C-1286	02
REV.NO.	DRAWING REVISED AS PER CUSTOMER COMMENTS/INPUT RECEIVED ON 15&23.05.12	12.06.12	ANAND					TYPICAL CROSS SECTIONAL, ACCESS DOOR, RUBBER BELLOW, & ENCLOSURE FLANGE DETAIL FOR 11KV, 2500A SPB.		

SPACEGEAR SWITCHGEARS LIMITED

AS BUILT DRAWING

JOB NO. BD11-283

SHEET NO. 19

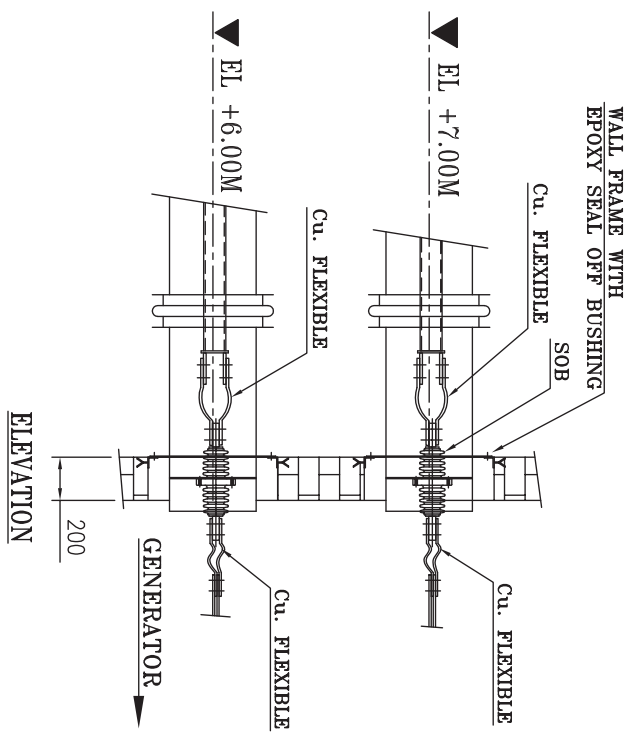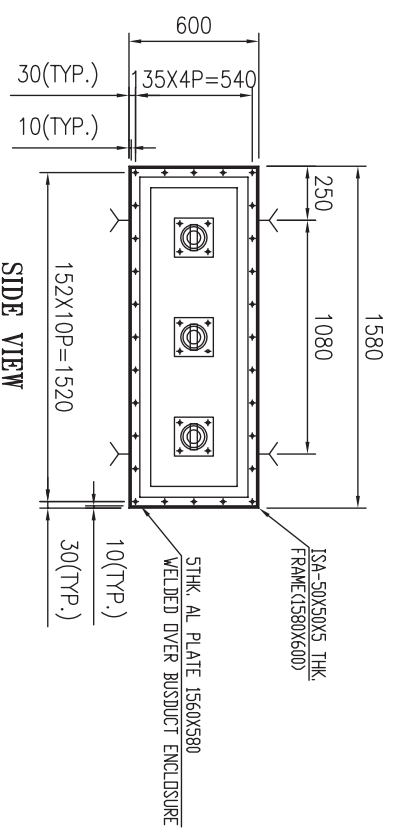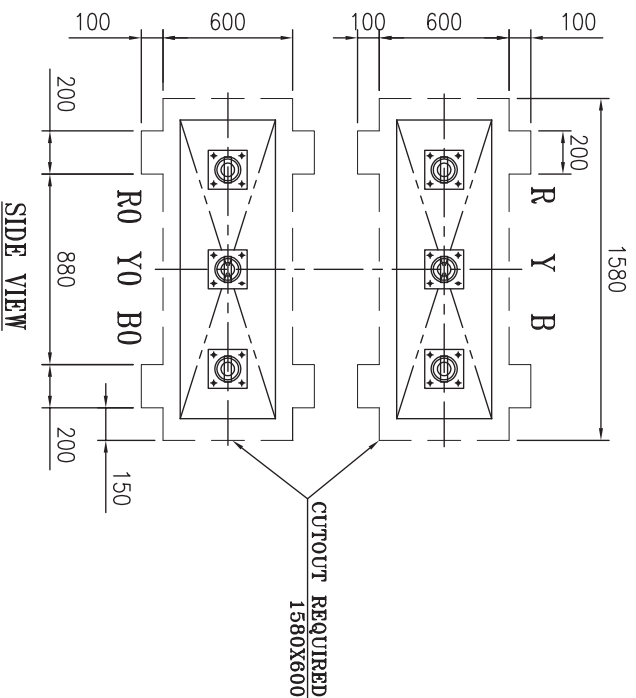

DRILLING DETAIL OF WALL FRAME & ENCLOSURE PLATE
 TOTAL QTY. 03 NOS. (02 NOS. WITH SOB & 01 NO. WITHOUT SOB.)

02	AS BUILT DRAWING	18.12.12	ANAND	APPD.	V.PAL	CUSTOMER : M/S BHARAT HEAVY ELECTRICALS LTD. HYDERABAD.	CONSULTANT : AVANT-GARDE ENGINEERS AND CONSULTANTS (P) LTD. CHENNAI	68, INDUSTRIAL DEVELOPMENT COLONY, GURGAON-122001	DRG. TITLE: WALL/FLDOR. FRAME ASSEMBLY DETAIL FOR 11KV, 2500A SPB.	DRG. NO. BD11-283C-1286	REV. NO. 02
01	DRAWING REVISED AS PER CUSTOMER COMMENTS/INPUT RECEIVED ON 15&23.05.12	12.06.12	ANAND	CHD.	ANAND						
REVND	DESCRIPTION OF CHANGE	DATE	SIGN.								

- NOTES:-
1. ALL DIMENSIONS ARE IN mm UNLESS OTHERWISE SPECIFIED.
 2. MS FRAME OF WALL FRAME SHALL BE HOT DIP GALVANIZED.
 3. ALL BOLTS, NUTS AND WASHERS SHALL BE MS Zn PLATED.

AS BUILT DRAWING

SPACEAGE SWITCHGEARS LIMITED

JOB NO.
BD11-283

SHEET NO.
21


TYPE-K7

TOTAL QTY.-04NOS (FOR NGT TIE RUN)

INSERT PLATE OF SIZE
250X200X10 THK
PROVIDED BY CUSTOMER

EL +10.0M

150X100X10 THK.

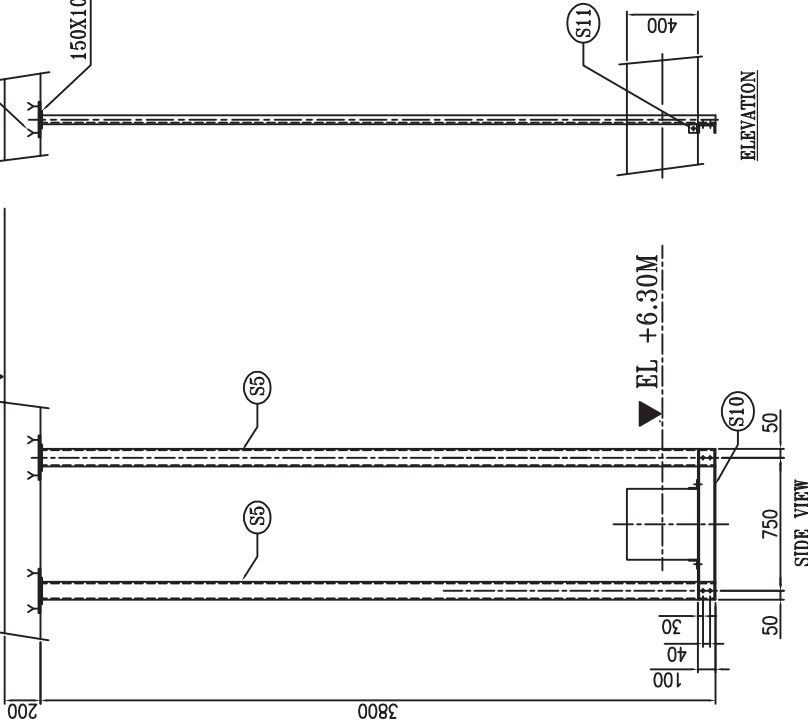

S.NO.	ITEM NO.	MEMBER DESCRIPTION	MEMBER SIZE		TOTAL QTY.
			LENGTH		
1.	S1	1-ISM C-100 WITH 1-150X100X10THK. PLATE	785		06
2.	S2	1-ISM C-100 WITH 2-100X50X10THK. PLATE	950		04
3.	S3	1-ISM C-100 WITH 2-100X50X10THK. PLATE	1300		04
4.	S4	1-ISM C-100 WITH 1-150X100X10THK. PLATE	1920		02
5.	S5	1-ISM C-100 WITH 1-150X100X10THK. PLATE	3800		10
6.	S6	1-ISM C-100	1830		05
7.	S7	1-ISM C-100 WITH 1-150X100X10THK. PLATE	3100		06
8.	S8	1-ISM C-100 WITH 1-150X100X10THK. PLATE	2850		02
9.	S9	1-ISM C-100	100		02
10.	S10	1-ISM C-100	850		04
11.	S11	ISA-50X50X5 THK.	50		18
12.	---	M12X50+2PW+1SW+N	---		80
13.	---	ISA 50X50X5 THK. FOR WALL FRAME	=1580+600)X4		04

AS BUILT DRAWING		CUSTOMER :		DRN.	DATE	JOB NO.	
		M/s BHARAT HEAVY ELECTRICALS LTD. HYDERABAD.		ANAND	11.05.12	BD11-286	
		CONSULTANT :		CHD.	ANAND	SHEET NO.	
03	AS BUILT DRAWING	AVANT-GARDE ENGINEERS AND CONSULTANTS (P) LTD. CHENNAI				23	
02	DRAWING REVISED AS PER CUSTOMER COMMENTS/INPUT RECEIVED ON 23.06.12	PROJECT :		APPD.	V.PAL	REV. NO.	
01	DRAWING REVISED AS PER CUSTOMER COMMENTS/INPUT RECEIVED ON 15&23.05.12	LAKHANGAL MAULI INDUSTRIES LTD. 1 X 30 MW STG, DSMANABAD, MAHARASHTRA				DRG.ND.	
REVND	DESCRIPTION OF CHANGE	68, INDUSTRIAL DEVELOPMENT COLONY, GURGAON-122001				BD11-283C-1286	