

**SubContracts DEPT
BHEL PSSR CHENNAI
Corrigendum-1,dt:5/7/2016**

BHEL's clarifications are furnished below against some of the bidder's query sought vide letters/email in Tender Specification BHEL PSSR SCT 1628 for Execution of STG work at 1 X 800 MW Kothagudem TPS, Telangana State .

Sino	DOCUMENT	CLAUSE NO	EXISTING PROVISION	BIDDER QUERY	BHEL Clarification
1	TCC	1.14.1.23	The tube shall be inserted such that it shall project 2 to 3 mm beyond the tube plate outer surface. The tube shall be expanded using an automatic electronic torque control tube expanding unit or pneumatic tube expander so as to get the % thinning of the tube walls and elongation of tube ends as recommended by the supplier / Drawing / Tube expansion procedure. The length of expansion in no case shall exceed a length of 70 to 80% of the tube plate thickness. Finally, proper trimming of the excess length of the tube shall be carried out and flare-up / bell mouting has to be done by the contractor at his cost.	Please confirm the scope of supply for the Automatic electronic torque control/pneumatic tube expander machine	Supply of T&P as per Vol 1A, Part I, Chapter IV
2	TCC	1.14.1.23	The tube shall be inserted such that it shall project 2 to 3 mm beyond the tube plate outer surface. The tube shall be expanded using an automatic electronic torque control tube expanding unit or pneumatic tube expander so as to get the % thinning of the tube walls and elongation of tube ends as recommended by the supplier / Drawing / Tube expansion procedure. The length of expansion in no case shall exceed a length of 70 to 80% of the tube plate thickness. Finally, proper trimming of the excess length of the tube shall be carried out and flare-up / bell mouting has to be done by the contractor at his cost.	Please confirm any stitch welding is applicable between tube and tube walls.	Stich welding is not applicable
3	TCC	1.9.1	Weight Schedule Summary D. Pumps and Motors (BFP,CEP, CW Etc.,)	The summation of weight given is 10,07,610 Kgs. But the actual summation is 54,04,110 Kgs. Please Confirm	Item D.28 to be read as other misc. Hardware is 4,88,500 Kg.However the summation given in tender is in order.
4	TCC	16.16	PRIMER AND PAINTS FOR FINAL PAINTING	Please provide BHEL/Customer approved agency list for the supply of Paints	Customer Approved Agency will be provided after award of contract.
5	TCC	1.12.17	Grouting of equipments is included in the scope of contractor. All the materials required for grouting including special cements like PAGEL, CONBEXTRA- GP2, SHRINKOMB or its equivalent grade free flow cement as approved by BHEL and other materials like Portland cement, sand, gravel etc., are to be arranged by the contractor within the quoted rate. It shall be the responsibility of the contractor to obtain prior approval of BHEL, regarding suppliers, type of grouting cements before procurement of grouting cements.	Kindly specify the volume of grouting	Vendor to refer Clause 1.12.19
6	TCC	Chapter II, clause no: 1.2.9	"Obtaining clearances and approvals from all applicable statutory / Government agencies e.g. IBR, Electrical Inspectorate etc. is also in the scope of contractor	As TG integral piping erection work only included in this package, should we take any permission from IBR inspectorate for execution of TG package? Kindly confirm.	Statutory clearances , if any applicable as mentioned in the tender is in the scope of the vendor.
7	TCC	chapter V, clause no 1.5.3.2	portable gantry: crane erection, load test , commissioning and dismantling etc are in the scope of contractor	Please confirm the portal gantry crane tonnage details for erection. We presume M/s BHEL will provide the load at site for load test. What will be the maximum weight of load sections to be handled at site. And also please clarify the scope of supply of paint for touch up painting	Portal gantry crane is 512 MT. Vendor to refer Clause 1.5.3.2.

**SubContracts DEPT
BHEL PSSR CHENNAI
Corrigendum-1,dt:5/7/2016**

BHEL's clarifications are furnished below against some of the bidder's query sought vide letters/email in Tender Specification BHEL PSSR SCT 1628 for Execution of STG work at 1 X 800 MW Kothagudem TPS, Telangana State .

Sino	DOCUMENT	CLAUSE NO	EXISTING PROVISION	BIDDER QUERY	BHEL Clarification
8	TCC	chapter IX, Clause No 1.9.1	BOQ, Sr. No E BOI items, there is no weight details given for following items.	Provide tonnage details of following items of BOI, a. Hydraulic Unit Assembly (Sr. No 46 of BOI) b. Generator Integral piping (Sr. No 47 of BOI) including valves & fittings c. Hydrogen coolers piping (Sr No 48 of BOI) d. Turbine oil (No of Drums / barrels) (Sr no.63) e. Turbine Integral Piping (Sr. No 66 of BOI) including valve f. H&S for turbine and generator integral piping (Sr. No. 67 of BOI) g. LP by pass stop & control valves (Sr. No 71 of BOI) h. Misc. Cranes, Electric hoists, chain pulley blocks (sr. No 85 of BOI) Details of cranes, hoists & chain pulley blocks and specific equipment / area to be confirmed.	Tentative Quantities as as below: 1. Hydraulic unit assembly---4.416 MT 2. Generator integral piping---14.852 MT (Gas system, seal oil, LDR, Primary Water, Waste gas system, Waste Fluid system) 3. Hydrogen cooler piping---7.036 MT 4. Turbine oil (No. of drums)---261 Drums 5. Turbine integral piping---45.922 MT (Lube oil, H&S for turbine and generator integral piping---18.249 MT 6. H&S for turbine and generator integral piping---18.249 MT 7. LP bypass stop and control valves---24.37 MT (Valves, Actuator & Hydraulic unit) & 0.5 MT (Control oil piping) 8. The tentative list is as below, list is not exhaustive. Misc Cranes 1. 8T Single Girder EOT crane in Air compressor Building – 1 No 2. 5T Single girder EOT cranes in Fire water Pump house- 1 No 3. 8T single girder EOT crane in DG room – 1 No 4. 8 T single girder EOT crane in CWPH – 1 No 5. 5T single girder EOT crane in ACW pump house- 2 Nos Misc Hoists: erection upto junction box in scope of vendor 1. AC plant room hoist 5T – 1 No 2. Vacuum pump handling – 5T – 2 No 3. DMCW pump handling – 5T – 2 no 4. Drip pump 5T- 2 No 5. DM Transfer Pump – 2T- 2No 6. Vacuum pump handling 3T- 2 Nos 7. Lube oil unloading 3T- 1 No 8. Condensate transfer pump 3T- 1 No 9. 8.4 Metre level at ESP building 3T- 2 Nos 10. 16.7 metre level at ESP building 3T – 2 Nos 11. Elevator M/c room (TG building) 3T – 2 Nos 12. Elevator M/s Room (ESP building) 3T – 2 Nos 13. Boiler MCC room -10T – 2nos 14. Cw Bay handling 15 T – 2 Nos
9	TCC	Chapter No XIV, clause no 1.14.1.10	Generator stator may be unloaded away from the A row columns and in such case dragging of stator and bringing it to the unloading point is in the scope of contract	M/s BHEL to confirm whether Generator stator is brought under the portal gantry crane reach (or) unloaded away from the A row column. What would be the max. distance if it is unloaded away from the "A" row columns since dragging of generator to the reach of portal gantry crane from the unloaded point has additional cost implication	Generator Stator will be brought at lifting position of the portal gantry crane.
10	TCC	chapter no: XIV, clause no 1.14.1.32	sand Grit /shot blasting of condenser is in the scope of contractor	M/s BHEL to confirm the tentative surface area of condenser, Water box and tube sheet in square meter for the estimation purpose	condenser drawings is enclosed for information and the same may be revised during execution.


**SubContracts DEPT
BHEL PSSR CHENNAI
Corrigendum-1,dt:5/7/2016**

BHEL's clarifications are furnished below against some of the bidder's query sought vide letters/email in Tender Specification BHEL PSSR SCT 1628 for Execution of STG work at 1 X 800 MW Kothagudem TPS, Telangana State .

S/no	DOCUMENT	CLAUSE NO	EXISTING PROVISION	BIDDER QUERY	BHEL Clarification
11	TCC	Nil	General	BHEL to provide the list of major T&P such as Crane, trailer,hydra etc. to be deployed by contractor other than the T&P provided by M/s BHEL for Material handling purpose i.e., loading at store,transportation and unloading at site etc for loading the cost	Supply of T&P as per Vol 1A, Part I, Chapter IV
12	TCC	Nil	General	Regarding Excess Piping Quantity - If there is any increase in the tendered TG integral piping quantity (above +15%), the quantity exceeding +15% of tendered quantity shall be paid @ unit rate / MT arrived on the basis of Total BBU % provided for integral piping (i.e,13.6% of LS price) divided by tendered quantity of TG integral piping because the piping erection cost shall not be the same of equipment erection cost.	Tender conditions prevail
13	Nil	General	Time Extension-We are studying the scope of work and have sent some queries which have to be clarified by M/s BHEL and our site visit is still pending due to pre-occupations.	Request you to kindly extend the due date of submission of above tender up to 15-07-2016	Time extension for bid submission is not possible due to administrative reasons,hence bidders are requested to submit their offers as per the schedule indicated in the tender

All other conditions remain unchanged

AGM/SCT

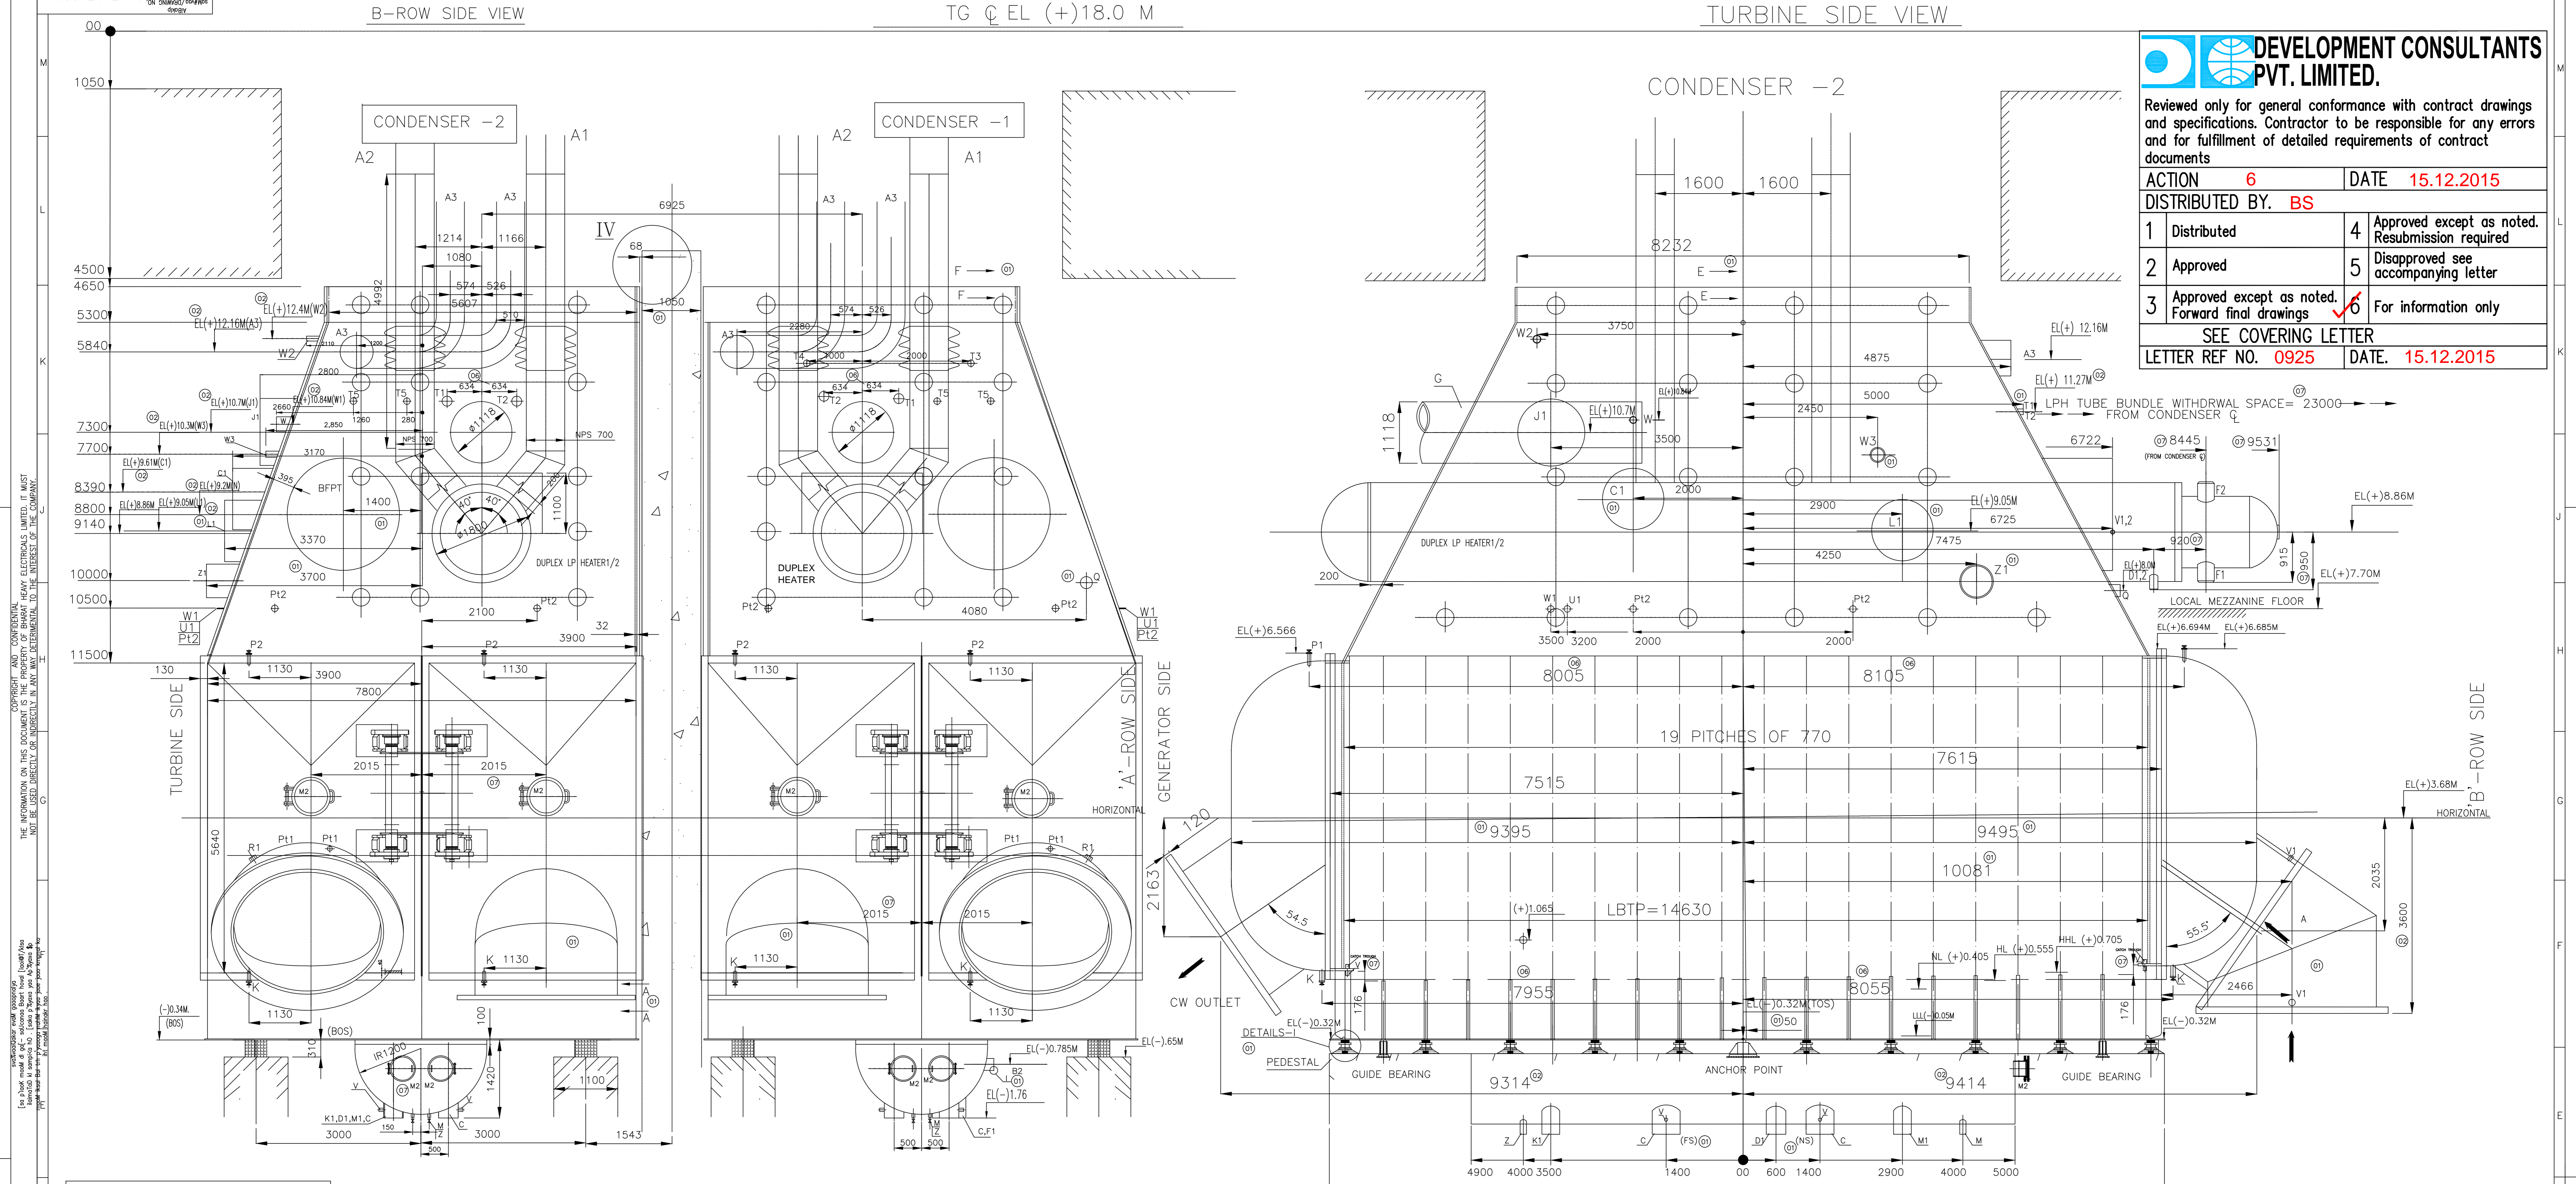

DEVELOPMENT CONSULTANTS PVT. LIMITED.
 Reviewed only for general conformance with contract drawings and specifications. Contractor to be responsible for any errors and for fulfillment of detailed requirements of contract documents





ACTION 6		DATE 15.12.2015	
DISTRIBUTED BY. BS			
1 Distributed	4 Approved except as noted. Resubmission required		
2 Approved	5 Disapproved see accompanying letter		
3 Approved except as noted. Forward final drawings	6 For information only		

SEE COVERING LETTER
 LETTER REF NO. **0925** DATE. **15.12.2015**

COPYRIGHT AND CONFIDENTIAL
 THE INFORMATION ON THIS DOCUMENT IS THE PROPERTY OF BHARAT HEAVY ELECTRICALS LIMITED. IT MUST NOT BE REPRODUCED OR TRANSMITTED IN ANY FORM OR BY ANY MEANS, ELECTRONIC OR MECHANICAL, INCLUDING PHOTOCOPYING, RECORDING, OR BY ANY INFORMATION STORAGE AND RETRIEVAL SYSTEM, WITHOUT PERMISSION IN WRITING FROM BHARAT HEAVY ELECTRICALS LIMITED.

UNLESS OTHERWISE STATED WELD EDGE PREPARATION OF BUTT WELD PIPE CONNECTIONS


SPACE REQUIREMENT FOR WATER BOX REMOVAL AND TUBE WITHDRAWAL

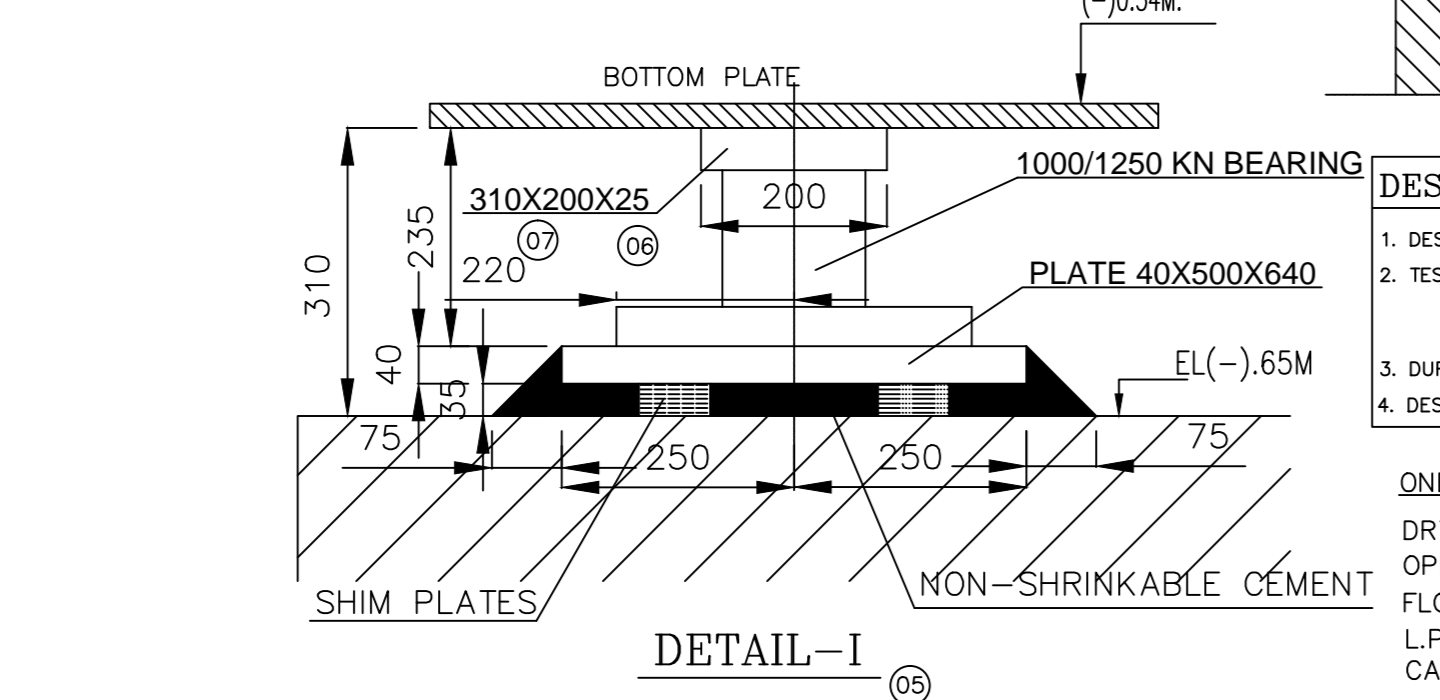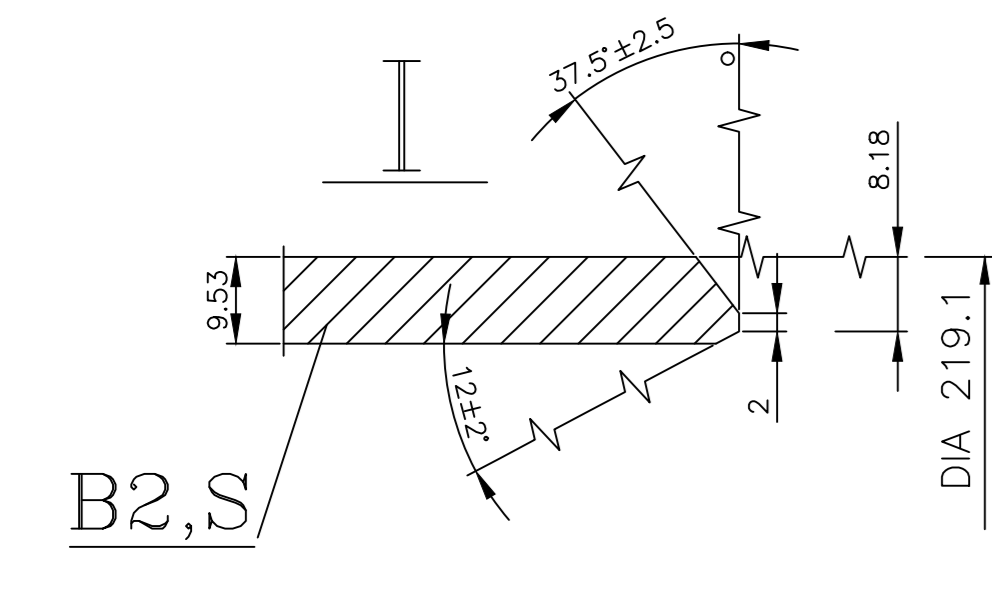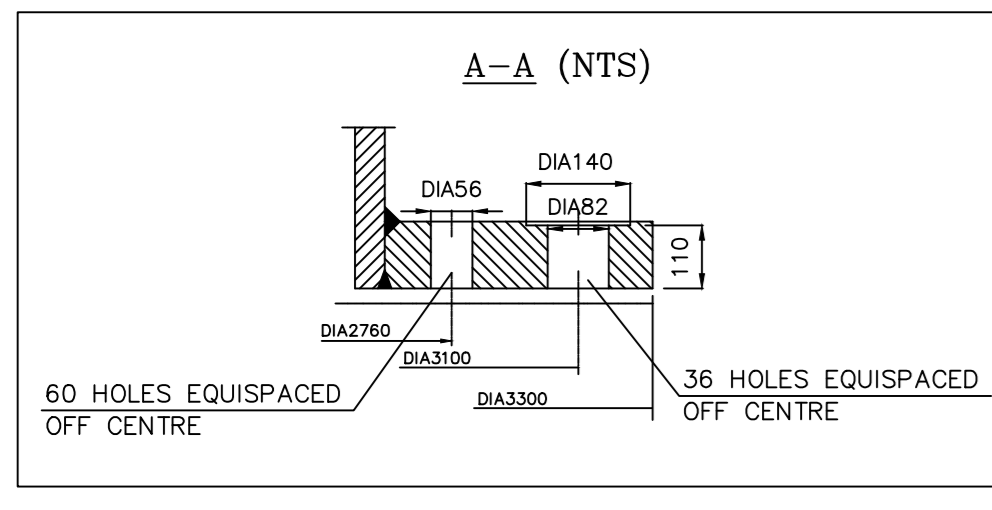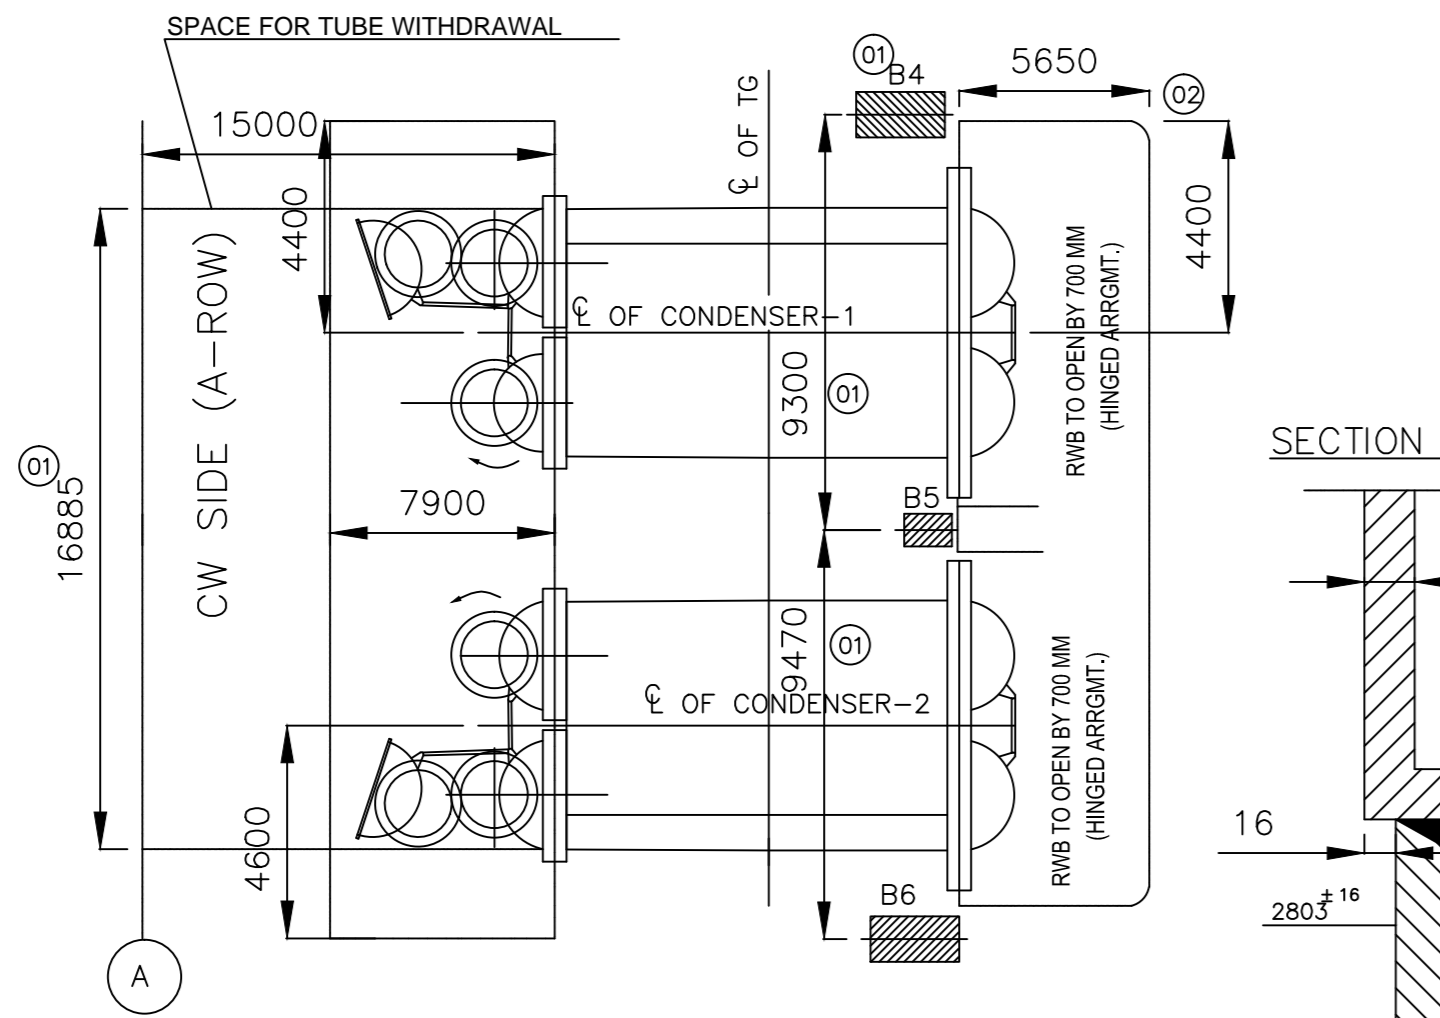

DESIGN CONDITION	STEAM SIDE	WATER SIDE
1. DESIGN PRESSURE	FULL VAADAM @ 1.08kg/cm ² (g)	0.1 Kg/cm ² (abs) @ 5.8 Kg/cm ² (g)
2. TEST PRESSURE	FILLING WATER UP TO 500 MM ABOVE FINAL WATER LEVEL IN CONDENSER (DRAINED) NEAR TO TURBINE (1.40kg/cm ² (g))	7.28 Kg/cm ² (g)
3. DURATION OF TEST	24 HOURS (MIN)	30 MINUTES (MIN)
4. DESIGN TEMPERATURE	120°C	60°C

ONE CONDENSER WEIGHT: (G)
 DRY WEIGHT - 600 T (EXCL. LP HEATER WEIGHT)
 OPERATING WEIGHT - 950 T
 FLOODED WEIGHT - 1750 T
 LP TURBINE OUTER - 110 T
 CASING WEIGHT

KEY PLAN

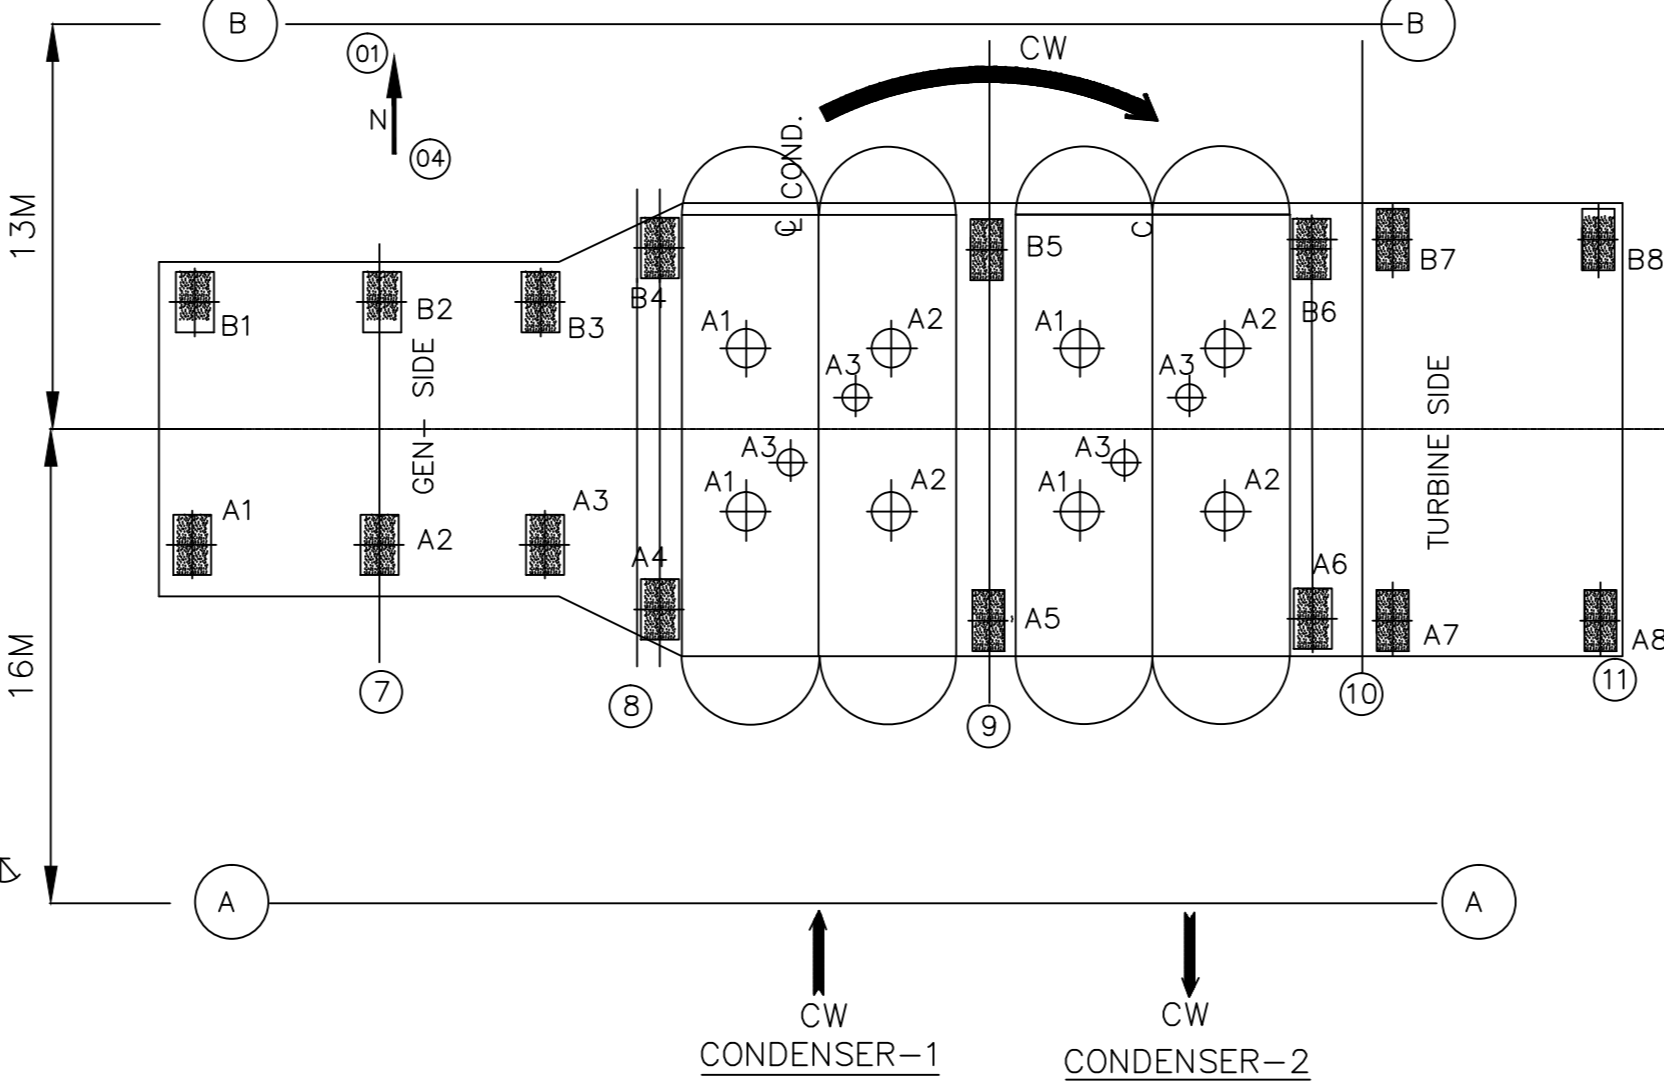

DESIGN DATA:-

- COOLING WATER FLOW = 84210 M³/HR
- COOLING SURFACE AREA (DESIGN) = 2x34736 M²
- COOLING WATER INLET TEMPERATURE (DESIGN) = 33 °C
- COOLING WATER TEMPERATURE RISE = 9.4 °C (4.72°C + 4.68 °C)
- NUMBER OF TUBE PASSES = 1
- TUBE CLEANLINESS FACTOR = 0.9
- COOLING WATER SIDE PRESSURE DROP (PRESSURE DROP INDICATED ABOVE IS BETWEEN C.W. INLET OF CONDENSER-1 AND C.W. OUTLET OF CONDENSER-2) = 2x27673 NOS.
- NO. OF COOLING TUBES (TOTAL) = 2x2082 NOS.
- AIR COOLING ZONE = DIA 25.4 X 0.859, L=14730 MM (COMPLETE LENGTH) (FOR TOP TWO ROWS)
- SIZE OF COOLING TUBE = DIA 25.4 X 0.859, L=14730 MM (COMPLETE LENGTH)
- MATERIAL OF COOLING TUBES - CONDENSING ZONE = WELDED SS (ASTM A-249-TP304) - AIR COOLING ZONE AND TOP TWO ROWS = ALLOY STEEL P-11
- CONDENSER HOTWELL STORAGE CAPACITY BETWEEN NORMAL WATER LEVEL AND LOW LOW WATER LEVEL = 2x51.66 CUBM (3 MINUTES STORAGE CAPACITY)
- CORROSION ALLOWANCE: a) WATER BOX, TUBE PLATE = 3.2 MM b) SHELL, HOTWELL CONDENSER NECK = 1.6 MM
- HEAT LOAD = 397.5 Gcal/HR (CONDENSER-1) & 392.5 Gcal/HR (CONDENSER-2) = WVO 15% rfu = 0.0774 ata (CONDENSER-1) & 0.0992 ata (CONDENSER-2)
- DESIGN CONDITION CONDENSER BACK PRESSURES

LIST OF MATERIALS:- (MAJOR PARTS)

S.NO.	DESCRIPTION	MATERIAL	REV.	DATE	ALTERED DEEPAK KUMAR	REV.	DATE	ALTERED DEEPAK KUMAR	REV.	DATE	ALTERED DEEPAK KUMAR
1	BOTTOM PLATE, SUPPORT PLATES, DOME WALLS, WATER BOX, SHELL, HOTWELL	IS 2002, Gr. B	04	27.06.15	CHECKEDNAVEN PRKASH	01	05.04.15	CHECKEDNAVEN PRKASH	02	19.05.15	CHECKEDNAVEN PRKASH
2	MAIN TUBE PLATES	IS 2002, Gr. B				03	17.06.15	CHECKEDNAVEN PRKASH	03	17.06.15	CHECKEDNAVEN PRKASH
3	BAFFLES IN A.C. ZONE	SSTP 304				04	17.06.15	CHECKEDNAVEN PRKASH	04	17.06.15	CHECKEDNAVEN PRKASH
4	PIPES	IS 1239, Gr. ERW				05	10.09.15	CHECKEDNAVEN PRKASH	05	10.09.15	CHECKEDNAVEN PRKASH
5	THE ROD	IS 1590, Q235 CB				06	10.09.15	CHECKEDNAVEN PRKASH	06	10.09.15	CHECKEDNAVEN PRKASH
6	DUMP PIPE	ALLOY STEEL P-11				07	17.11.15	CHECKEDNAVEN PRKASH	07	17.11.15	CHECKEDNAVEN PRKASH
7	BOLTS & NUTS	ALLOY STEEL CL. 8.8 @				08	10.09.15	CHECKEDNAVEN PRKASH	08	10.09.15	CHECKEDNAVEN PRKASH
8	GASKET	NORBON				09	10.09.15	CHECKEDNAVEN PRKASH	09	10.09.15	CHECKEDNAVEN PRKASH
9	NOZZLES	CARBON STEEL				10	10.09.15	CHECKEDNAVEN PRKASH	10	10.09.15	CHECKEDNAVEN PRKASH

NOTE:-
 1. CONDENSER IS TO BE DESPATCHED IN LOOSE PARTS MAINLY COMPRISING OF THE FOLLOWING:
 i) BOTTOM PLATE
 ii) TURBINE AND GENERATOR SIDE WALL PLATES.
 iii) DOME WALLS
 iv) FRONT WATER CHAMBERS AND REAR WATER CHAMBERS WITH TUBE PLATES
 v) TUBE SUPPORT PLATES 2X18 NOS. PER CONDENSER.
 vi) FIXED SUPPORTS (MULTI BALL BEARINGS).
 vii) WATER BOX HINGE ARRANGEMENT FOR FRONT & REAR WATER BOXES.
 2. FOR INSTRUMENTATION & FITTING FOR CONDENSER LEVEL CONTROL REF. DRG. NO. 1160007000C209
 3. BOTH CONDENSERS TUBES ARE TILTED BY 0.5° TOWARDS A-ROW SIDE FOR SELF DRAINING.
 4. CONDENSATE LEVEL IN EACH CONDENSER IS DIFFERENT.
 5. EL. 0.00M CORRESPONDS TO RL 99.5M I.E. TTL OF TG HALL.
 6. CONDENSER IS DESIGNED, MANUFACTURED AND TESTED AS PER IHLUSA.
 7. THE EMBEDMENTS PROVIDED ARE FOR ANCHORING & GUIDING CONDENSER MOVEMENTS.
 8. MITRE IS THE PART OF WATER BOX AND WILL SUPPLY BY BHEL-PEM.
 9. LARGE BOX TYPE SCREENING STRUCTURE WITH ANTI-VORTEX BAFFLING IS PROVIDED AT EACH HOTWELL CONNECTION TO SUCTION OF CONDENSATE PUMPS.


CUSTOMER: **TELANGANA STATE POWER GENERATION CORPORATION LTD**
 TELANGANA STATE, INDIA
 1x800 MW KOTHAGUDAM TPS STAGE-VII UNIT#12, PALONCHA

OWNER'S CONSULTANT: **DEVELOPMENT CONSULTANTS PVT. LTD.**
 CONSULTING ENGINEERS
 KOLKATA MUMBAI CHENNAI NEW DELHI

BHARAT HEAVY ELECTRICALS LTD
 HEER, HARIDWAR

REV.	DATE	ALTERED DEEPAK KUMAR	REV.	DATE	ALTERED DEEPAK KUMAR	REV.	DATE	ALTERED DEEPAK KUMAR
01	05.04.15	CHECKEDNAVEN PRKASH	01	05.04.15	CHECKEDNAVEN PRKASH	01	05.04.15	CHECKEDNAVEN PRKASH
02	19.05.15	CHECKEDNAVEN PRKASH	02	19.05.15	CHECKEDNAVEN PRKASH	02	19.05.15	CHECKEDNAVEN PRKASH
03	17.06.15	CHECKEDNAVEN PRKASH	03	17.06.15	CHECKEDNAVEN PRKASH	03	17.06.15	CHECKEDNAVEN PRKASH
04	17.06.15	CHECKEDNAVEN PRKASH	04	17.06.15	CHECKEDNAVEN PRKASH	04	17.06.15	CHECKEDNAVEN PRKASH
05	10.09.15	CHECKEDNAVEN PRKASH	05	10.09.15	CHECKEDNAVEN PRKASH	05	10.09.15	CHECKEDNAVEN PRKASH
06	10.09.15	CHECKEDNAVEN PRKASH	06	10.09.15	CHECKEDNAVEN PRKASH	06	10.09.15	CHECKEDNAVEN PRKASH
07	17.11.15	CHECKEDNAVEN PRKASH	07	17.11.15	CHECKEDNAVEN PRKASH	07	17.11.15	CHECKEDNAVEN PRKASH
08	10.09.15	CHECKEDNAVEN PRKASH	08	10.09.15	CHECKEDNAVEN PRKASH	08	10.09.15	CHECKEDNAVEN PRKASH
09	10.09.15	CHECKEDNAVEN PRKASH	09	10.09.15	CHECKEDNAVEN PRKASH	09	10.09.15	CHECKEDNAVEN PRKASH
10	10.09.15	CHECKEDNAVEN PRKASH	10	10.09.15	CHECKEDNAVEN PRKASH	10	10.09.15	CHECKEDNAVEN PRKASH

TITLE: **CONDENSER GENERAL ASSEMBLY**
 SHEET 01 OF 02
 DRAWING NO. **01601070071C209**
 SHEET 1 OF 2 REV. 07

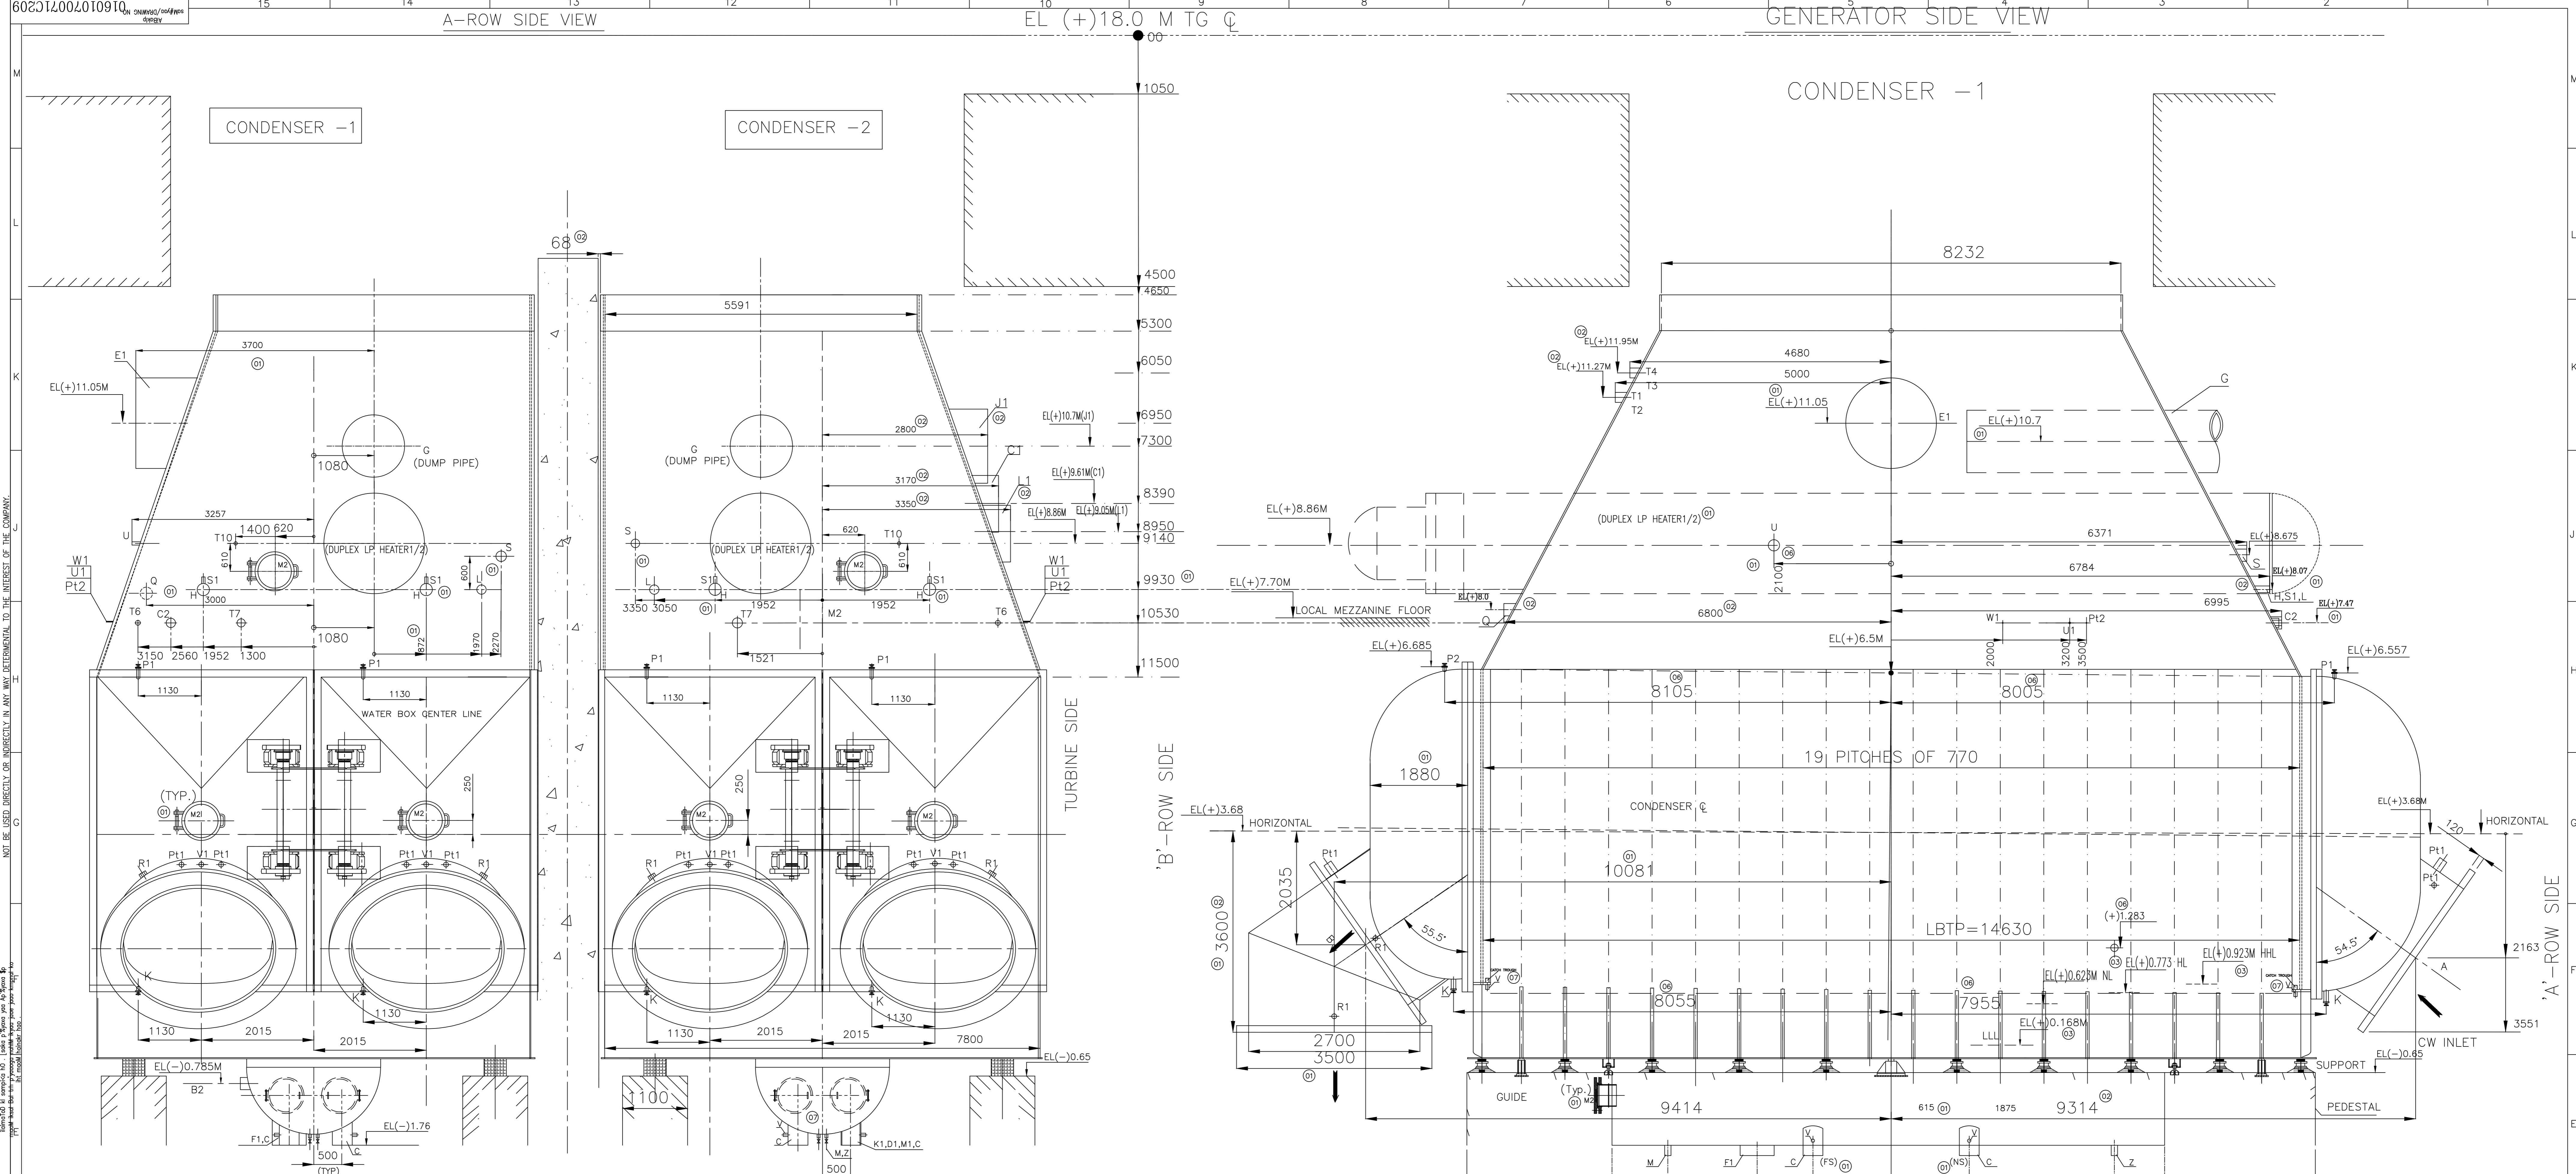


LIST OF FITTINGS / INSTRUMENTS:-

SL. NO.	SIZE	DESCRIPTION	QTY.	TYPE	REMARKS	MO.
01	NB 100	WATER BOX DRAIN VALVE	8	FLG. SW		CS
02	NB 100	HOT WELL DRAIN VALVE	8	FLG. SW		CS
03	NB 150	WATER BOX VENT VALVE	4	FLG.		CS
04	NB 25	ISOLATING VALVES FOR LEVEL SWITCHES	18	SW		CS
05	NB 25	ISOLATING VALVES FOR LEVEL GAUGE	16	SW	LEVEL GAUGES ARE PROVIDED WITH NON-RETURNING ISOLATING VALVE FOR LEVEL GAUGE ISOLATION	CS
06	NB 50	STAND PIPE ISOLATING VALVE	8	SW		CS
07	NB 15	STAND PIPE VENT VALVE	4	SW		CS
08	NB 15	STAND PIPE DRAIN VALVE	4	SW		CS
09	M 33x2	THERMOWELL M20X1.5 (FEMALE) IN WATER BOX	16	SCR	IMMERSION LENGTH L=325 mm	CS
10	M 33x2	THERMOWELL M20X1.5 (FEMALE) IN AIR OUTLET PIPE	4	SCR	L=125 mm	CS
11	M 33x2	THERMOWELL M20X1.5 (FEMALE) IN CONDENSER SHELL	2	SCR	L=325 mm	CS
12	-	LEVEL SWITCHES (MAGNETIC FLOAT TYPE)	6	SW		CS
13	NB 15	ISOLATING VALVE FOR CONDENSER VACUUM GAUGE	2	SW		CS
14	M20X1.5	DIAL THERMOMETERS FOR CW SIDE RANGE 0-80°C	8	SCF		CS
15	-	STAND PIPES (NB100)	4	-		CS
16	NB 50	ISOLATING VALVE FOR TRANSMITTERS	12	SW		CS
17	M 33x2	THERMOWELL M20X1.5 (F) IN WATER BOX (FOR PERFORMANCE TEST)	8	SCR	L=125 & 325 mm (Min. L&H) NO. EACH PIPE OR INLET CONN.	CS
18	NB 15	ISOLATING VALVE FOR CONDENSER VACUUM MEASUREMENT (FOR PERFORM. TEST)	12	SW		CS
20	NB 15	ISOLATING VALVE FOR CW PRESSURE GAUGE	8	SW		CS
T6	DIA 88.9x5.49	HEADER FOR CONDENSER INSTRUMENTS RACK	2	H16		
R1	M33x2	CW TEMPERATURE CONNECTION	8	F8	PLUG FITTED	
S1	M33x2	AIR OUTLET TEMPERATURE CONNECTION	4	H1	PLUG FITTED	
U1	M33x2	CONDENSER SHELL TEMP. CONNECTION	2	H7	PLUG FITTED	
V1	NB 15	CW PRESSURE GAUGE CONNECTION	8	G2	VALVE FITTED	
W1	NB 15	VACUUM GAUGE CONNECTION WITH VALVE	2	H7	VALVE FITTED	
Z1	DIA 457.2x7.92	EXCESS STEAM FROM SEAL STEAM HEADER	1	H4		
M2	DIA 508x10	MAN HOLES WITH HINGED COVERS	20	E4		
C2	DIA 168.3x7.11	RINSE WATER FROM POLISHER UNIT	1	H1	DISPENSER FITTED	
T5	M14x1	REMOTE TEMP MEASUREMENT FOR LP BY PASS SPRAY CONTROL	4	K1	PLUG FITTED	
PH1	M33x2	CW INLET TEMP. CONN. FOR PERFORM. TEST	8	G2	PLUG FITTED	
PH2	NB 15	COND. VACUUM MEASUREMENT CONN. TO LP BY PASS VALVE	2	H2	VALVE FITTED	
T10	DIA 33.4x4.55	EXCESS WATER FROM WATER SPRAY LINE TO LP BY PASS VALVE	2	H2		
W2	DIA 273.1x9.27	STEAM EVACUATION FROM HPT/GRH	1	K7		
Q	DIA 168.3x7.11	OSC MIN. REGULATION	1	H10		

LIST OF CONNECTIONS:-

REF.	SIZE OF (ODXKXJ)	TYPE	FLANGE DETAIL	NO. / HOLE	DESCRIPTION	QTY.	REMARKS
A	DIA 2780x40	FLG.	3500X3300 - - 120 254 2960	4 F2	CW INLET	4	* DIA OF HOLE
B	DIA 2780x40	FLG.	3500X3300 - - 120 254 2960	4 F8	CW OUTLET	4	* DIA OF HOLE
C	DIA 355.6x9.53	BW		4 E5	CONDENSATE OUTLET	4	
D	C2200x1100			2 J11	LP HEATER NO.1	2	
A1	DIA 700x10	BW		4 J11	EXTRACTION PIPE LPH-1	4	
A2	DIA 700x10	BW		4 J12	EXTRACTION PIPE LPH-2	4	
A3	DIA 610x10	BW		2 K12	EXTRACTION PIPE LPH-3	2	* FROM TURBINE NB500
G	DIA 118x32	BW		2 K8	LP BYPASS STEAM INLET	2	
H	DIA 219.1x6.35	BW		4 H11	AIR EXTRACTION	4	
K	DIA 114.3x35	FLG.	210 170 148 3 18 4/16/2	8 F11	WATER BOX DRAIN WITH VALVE	8	F11-1 DISPENSER FITTED COND-2 BUND FLANGE
L	OD 168.3x3.4	FLG.	210 170 148 3 18 4/16/2	8 H11	NORMAL EMERGENCY MAKE-UP CONNECTION	8	
M	DIA 114.3x6.02	SW		8 E11	HOT WELL DRAIN WITH VALVE	8	
N	DIA 203.2x16	BW		2 J10	BFP EXHAUST CONNECTION	2	
S	DIA 219.1x8.18	BW		2 H13	VACUUM BREAKER CONNECTION	2	
T1	DIA 168.3x7.11	BW		2 K13	LPH-1 VENT	2	
T2	OD 168.3x7.11	BW		2 K13	LPH-2 VENT	2	
T3	OD 114.3x6.02	BW		1 K14	LPH-3 VENT	1	
T4	OD 114.3x6.02	BW		1 K14	LPH-4 VENT	1	
U	OD 114.3x6.02	SW		1 J5	VENT FROM CONDENSATE EXTRACTION PIPES (EXHAUST SIDE)	1	
V	DIA 60.3x5.54	SCR		12 E5	CONDUCTIVITY MEASUREMENT CONNECTION	12	PLUG FITTED
W	DIA 114.3x6.02	BW		1 K6	LEAKAGES FROM U-RING HP INLET AND U-RING OVERLOAD VALVE TO HPT	1	
Z	NB 50	SW		8 E5	CONNECTION FOR STAND PIPES	8	STAND PIPE ERECTION
D1	DIA 118x10	BW		1 J8	FLASH TANK-A VENT (LP)	1	
D2	DIA 323.9x6.39	BW		1 E5	FLASH TANK-A DRAIN	1	
E1	DIA 118x10	BW		1 K5	FLASH TANK-B VENT (HP)	1	
F1	DIA 610x10	BW		1 E10	FLASH TANK-B DRAIN	1	
J1	DIA 1219x16	BW		1 K7	TURBINE FLASH BOX I VENT	1	
K1	DIA 323.2x7.1	BW		1 E7	TURBINE FLASH BOX I DRAIN	1	
L1	DIA 1219x16	BW		1 J5	TURBINE FLASH BOX II VENT	1	
M1	DIA 323.9x7.1	BW		1 E4	TURBINE FLASH BOX II DRAIN	1	
P1	DIA 168.3x7.11	FLG.	285 240 212 3 22 4/16/2	H2	WATER BOX STARTING VENT/AR RELEASE VLV. A	H2	BUND FLANGE FITTED (A--ROW SIDE)
P2	DIA 114	FLG.	210 170 148 3 18 4/16/2	H7	WATER BOX VENT RELEASE VALVE (B ROW SIDE)	H7	BUND FLANGE FITTED (B--ROW SIDE)
W3	DIA 88.9x5.49			J5	U-RING LEAK OFF FROM HP INLET AND HP EXHAUST	J5	
T7	DIA 33.4x4.55			H2	EXTRA TEMP. CONNECTION	H2	

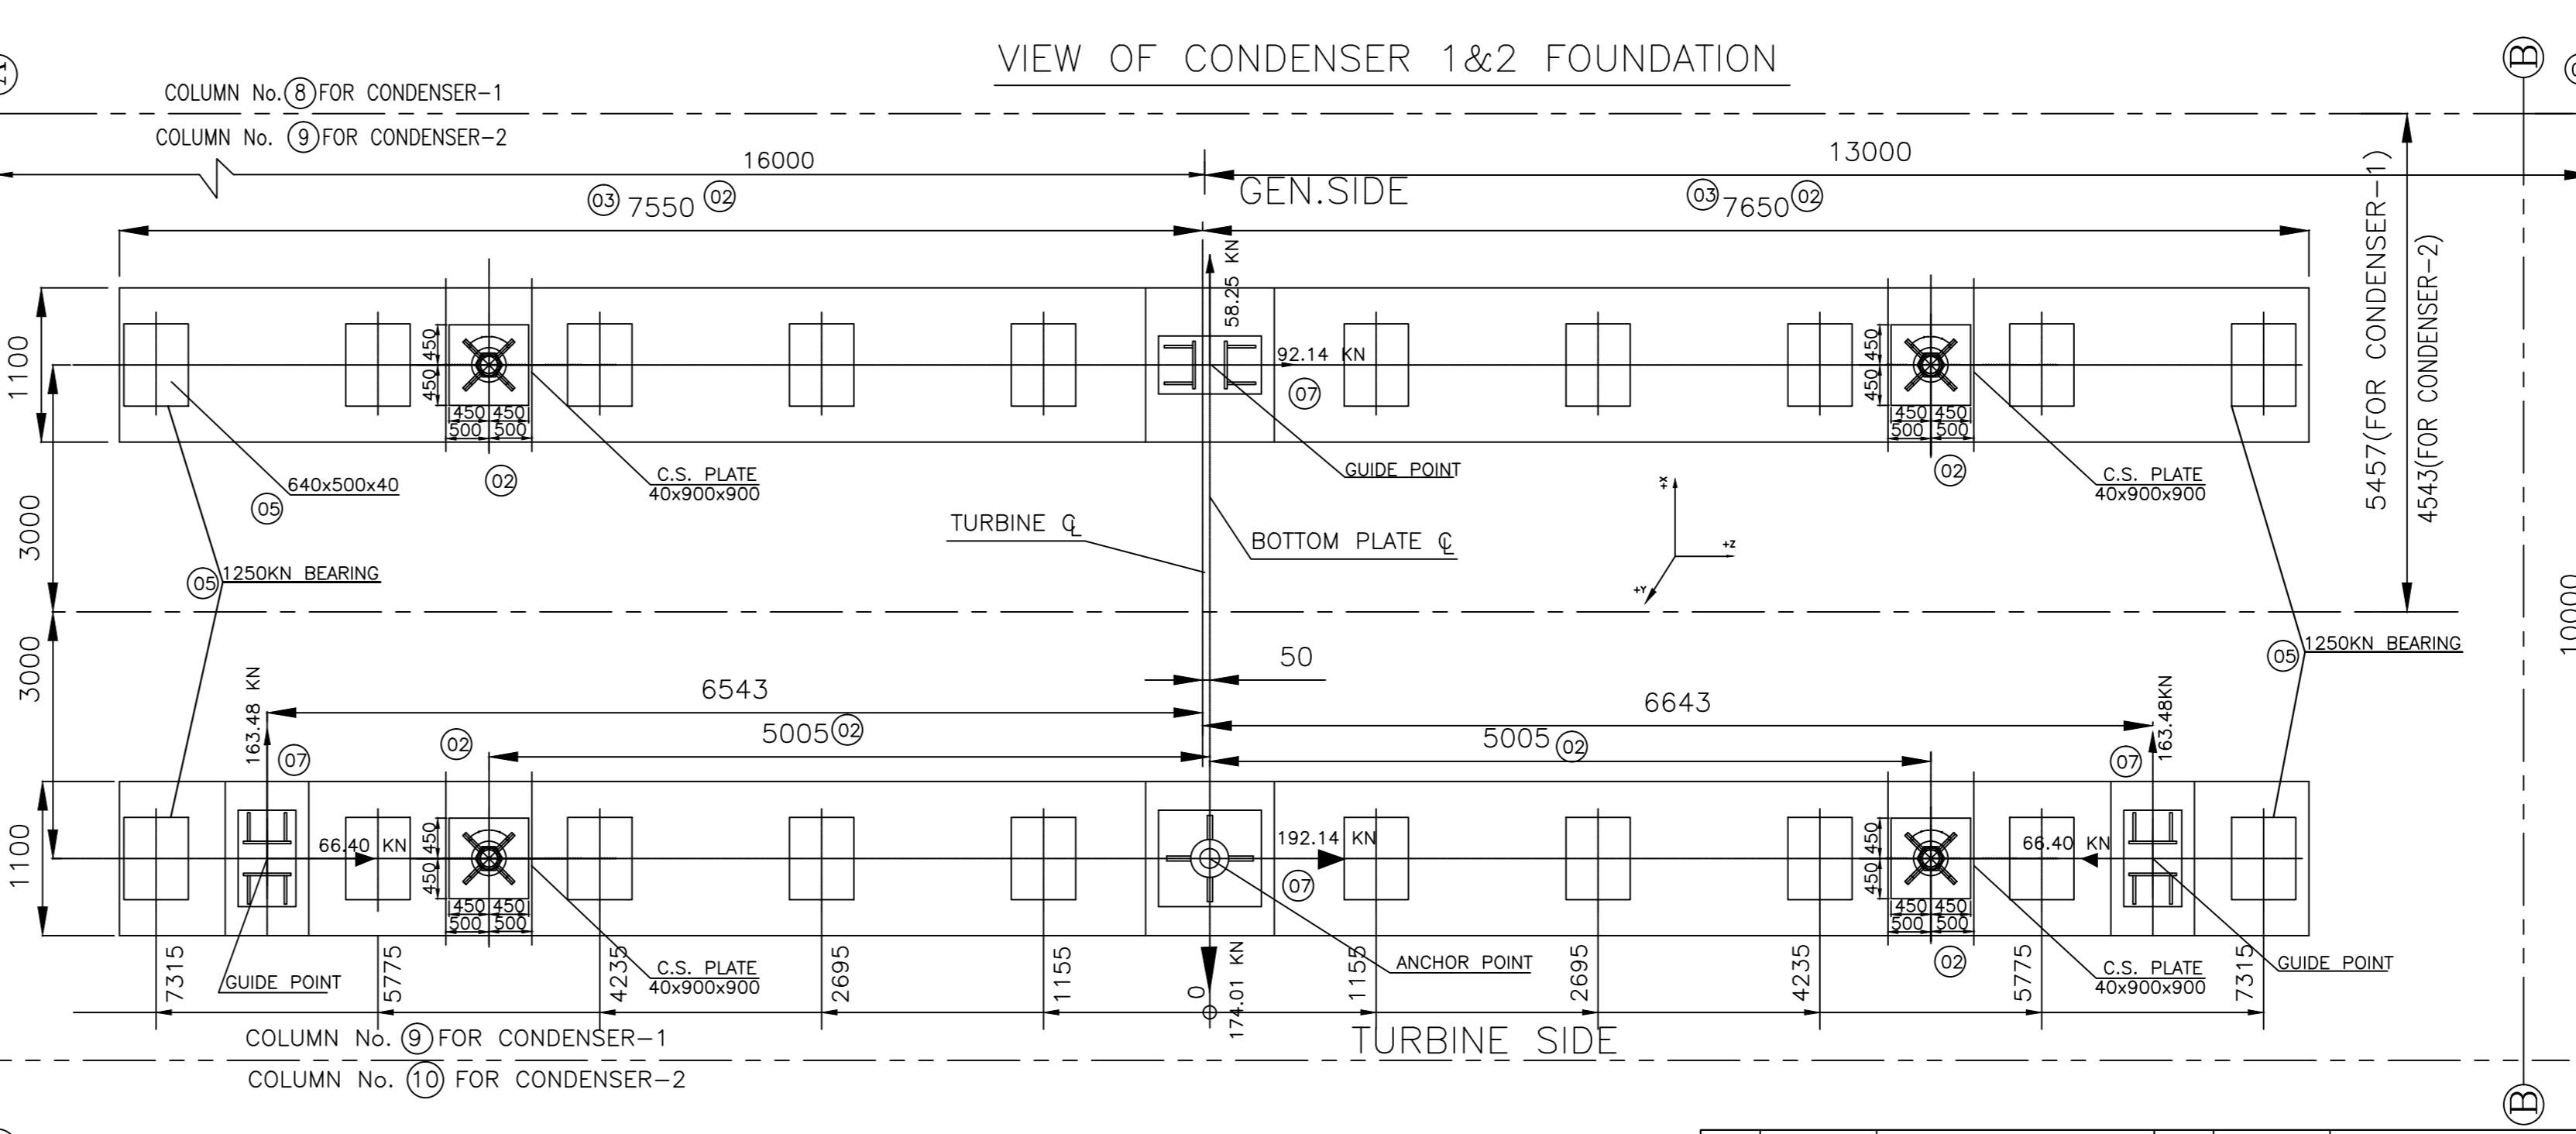

NOTE: EMBEDMENT PLATES DO NOT SUPPORT CONDENSER WEIGHT IN Y-DIRECTION (VERTICAL).

REV.	DATE	ALTERED DEEPAK KUMAR	REV.	DATE	ALTERED DEEPAK KUMAR	REV.	DATE	ALTERED DEEPAK KUMAR	REV.	DATE	ALTERED DEEPAK KUMAR
05	10.07.15	CHECKED NAVEEN PRAKASH	04	27.06.15	CHECKED NAVEEN PRAKASH	03	17.06.15	CHECKED NAVEEN PRAKASH	02	19.05.15	CHECKED NAVEEN PRAKASH
DRAWING REVISED TO INCORPORATE CUSTOMER COMMENTS.											
DRAWING REVISED TO INCORPORATE CUSTOMER AND PEM COMMENTS.											
DRAWING REVISED TO INCORPORATE CUSTOMER AND PEM COMMENTS.											
DRAWING REVISED TO INCORPORATE CUSTOMER AND PEM COMMENTS.											
DRAWING REVISED TO INCORPORATE CUSTOMER AND PEM COMMENTS.											

CUSTOMER: TELANGANA STATE POWER GENERATION CORPORATION LTD
 TELANGANA STATE, INDIA
 1x800 MW KOTHAGUDAM TPS STAGE-VII UNIT#12, PALONCHA

OWNER'S CONSULTANT: DEVELOPMENT CONSULTANTS PVT. LTD.
 CONSULTING ENGINEERS
 KOLKATA MUMBAI CHENNAI NEW DELHI

PREPARED BY: BHARAT HEAVY ELECTRICALS LTD
 HEER, HARIDWAR

DEPT. CODE: 4222
DESIGN. D.K.
CHKD. D.K.
APP'D. N.P.

NAME: sdr/-
SIGN: sdr/-
DATE: 20.02.15
 20.02.15
 20.02.15

TITLE: CONDENSER GENERAL ASSEMBLY

DEPT. SCALE NTS: SHEET 2 OF 2
DRAWING NO: 01601070071C209
REV.: 07

COPYRIGHT AND CONFIDENTIAL
 THE INFORMATION ON THIS DOCUMENT IS THE PROPERTY OF BHARAT HEAVY ELECTRICALS LIMITED. IT MUST NOT BE REPRODUCED OR TRANSMITTED IN ANY FORM OR BY ANY MEANS, ELECTRONIC OR MECHANICAL, INCLUDING PHOTOCOPYING, RECORDING, OR BY ANY INFORMATION STORAGE AND RETRIEVAL SYSTEM, WITHOUT THE WRITTEN PERMISSION OF BHARAT HEAVY ELECTRICALS LIMITED.