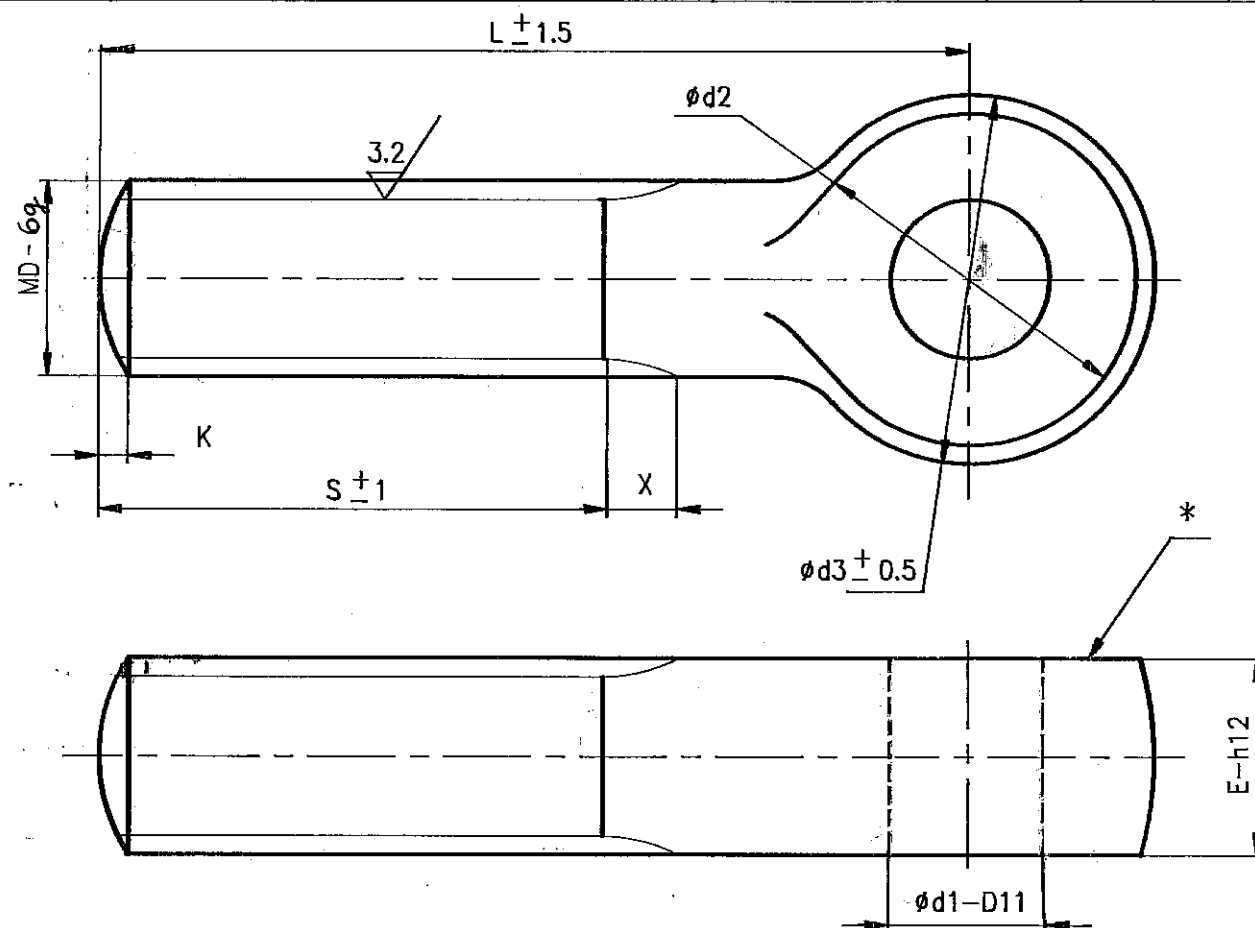


ALL DIMENSIONS ARE IN MILLIMETRES. FOR TOLERANCES OF UNTOLERANCED DIMENSIONS DURING MANUFACTURE REFER RELEVANT QCP / QP.

[illegible]

12.5 / 3.2

22 & 43





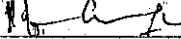

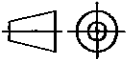
NOTES:

1. EYE BOLT SHOULD BE MADE OUT OF FORGING.
2. * PUNCH MATERIAL MARK "B7"
3. QUALITY REQUIREMENTS SHALL BE AS PER LATEST ~~APPLICABLE~~
~~QUALITY PROCEDURE~~

REDRAWN WITH REVISION NO. 03

REV	DATE	ALTD: MPS mps	REV	DATE	ALTD: PRE. 1/1/96	REV	DATE	ALTERED: MPS mps
05	4-12-98	CHD APPD SCS mps	04	1/6-1/96	CHD/APPD: SCS mps	03	28.03.96	CHD & APPD S.C.S. mps
TOLERANCE 6g GIVEN IN DIMN. MD.			NOTES UPDATED			NOTES 03 MODIFIED.		
DCN: QN: 0606			DCN: QN: 0454			DCN: QN: 0397		

CAUTION: The information on this document is the property of BHARAT HEAVY ELECTRICALS LTD. It must not be used directly or indirectly in any way detrimental to the interest of the company.

NO OFF	DESCRIPTION	MATL CODE	MATL SPECN	HEAT TREATMENT	SCRAP SORT	NET WT (kg)	GROSS WT (kg)	DRAWING No	ITEM No
TYPE OF PRODUCT OR NAME OF CUSTOMER/PROJECT									
QN									
 BHARAT HEAVY ELECTRICALS LTD., UNIT: HIGH PRESSURE BOILER PLANT. TIRUCHIRAPALLI-620014.					DRN	NAME M.P.S	SIGN 	DATE 27.5.96	NO. OF VAR.
					CHD	P.R.K.			
					APPD	S.C.S.		28/5/96	
DEPT VL		SCALE	WEIGHT (KG).		REFERENCE INFORMATION				NO. OF ITEMS
CODE 320		NTS			PT-40				
TITLE				CARD CODE	DRAWING NO.				REV
EYE BOLT				U 01	3-V-0000-22455				05